

Luminant  
1601 Bryan Street  
Dallas, Texas 75201

**RE: HISTORY OF CONSTRUCTION  
CCR SURFACE IMPOUNDMENTS, OAK GROVE SES  
ROBERTSON COUNTY, TX**

## 1.0 INTRODUCTION

The “Disposal of Coal Combustion Residuals (CCR) from Electric Utilities rule” (40 Code of Federal Regulations (40 CFR) Part 257), effective October 19, 2015, requires that existing CCR units meeting the requirements of §257.73(b) compile a history of construction, containing all the items, to the extent feasible, listed in §257.73(c)(1)(i) – (xii). This letter provides a history of construction pursuant to §257.73(c) for the Oak Grove Steam Electric Station’s (OGSES) CCR Impoundments, identified as flue gas desulphurization (FGD) Ponds FGD-A, FGD-B, and FGD-C.

## 2.0 OWNER AND OPERATOR - §257.73(c)(1)(i)

OGSES is currently owned and operated by Oak Grove Management Company LLC. The three FGD Ponds referenced in this letter have been assigned the following TCEQ WMU numbers.

- FGD-A 011
- FGD-B 012
- FGD-C 013

## 3.0 HISTORY OF CONSTRUCTION

OGSES is a lignite-fueled (i.e. coal-fired) power plant that commenced final construction activities in 2007. Golder Associates Inc. (Golder) has provided engineering services supporting construction of the Oak Grove CCR units since 2008.

### 3.1 Location - §257.73(c)(1)(ii)

OGSES is located in Robertson County, Texas, approximately 10 miles north of the City of Franklin. Figure 1 provides the location of the Power Plant with the FGD Ponds identified on the most recent U.S. Geological Survey (USGS) topographic map. Figure 2 provides an aerial map view of the power plant and its ancillary facilities.



### 3.2 Purpose - §257.73(c)(1)(iii)

The OGSES power plant produces coal combustion residuals (CCR's) in the form of fly ash, bottom ash and flue gas desulphurization (FGD) byproduct (gypsum). The CCR Surface Impoundments at OG that are covered by the CCR Rule (FGD- A, FGD- B and FGD-C) handle primarily the FGD gypsum. Fly ash and bottom ash are processed and transported by dry methods to Ash Landfill 1.

### 3.3 Watershed - §257.73(c)(1)(iv)

The embankments of all three ponds are raised above the surrounding ground surface; therefore, the surface impoundments are not affected by any adjacent watershed. However, in the event of a failure of the northern embankment in FGD-A, the contents of FGD-A could flow into FGD-B.

### 3.4 Foundation Materials - §257.73(c)(1)(v)

Preparation of FGD-A and FGD-B Pond's foundation occurred during the initial phase of construction in the 1980s. Golder conducted a subsurface investigation for FGD-A in 2008 and evaluated the existing liner in FGD-B in 2011. Based on a review of the available information and the subsurface investigations, the foundation soils at FGD-A and FGD-B Ponds consist of very stiff to hard clays and compact to very dense sands.

Continuous construction of FGD-C began on July, 12, 2015. Based on a subsurface investigation conducted by Golder in 2014, the foundation soils consist of a combination of fill and native clays and sands. Accurate identification of existing fill materials during drilling activities was not always possible, due to similarity with natural soils, not only in type but in relative consistency. In general, both the fill and native material consists of stiff to hard clays and compact to very dense sands.

### 3.5 Construction - §257.73(c)(1)(vi)

#### 3.5.1 Construction Materials and Site Preparation

The following sections provide details on the materials and site preparation methods employed during construction of each of the surface impoundments. Construction dates are provided in section 3.5.2 and specific construction documentation references are provided in section 3.10 of this letter.

##### 3.5.1.1 FGD-A Pond

The FGD-A Pond embankment was constructed of compacted site soils. No construction testing of the original embankment fill is available.

A compacted clay liner was installed within FGD-A in 2008. The clay was obtained from an on-site borrow source and compacted in 6-inch lifts to  $\geq 95\%$  of the maximum standard Proctor dry density and within +2% to +6% of the standard Proctor optimum water content. Based on testing of Shelby tube samples collected during clay liner construction, the 3-foot thick compacted clay liner has a hydraulic conductivity less than  $1 \times 10^{-7}$  cm/s.

##### 3.5.1.2 FGD-B Pond

The original FGD-B Pond embankment was constructed of compacted site soils. No construction testing of the original embankment fill is available.

In 2011, the base and embankment crest elevation of FGD-B Pond were raised and the pond was lined with a composite geomembrane/clay liner system. The subgrade was raised using structural fill to increase the separation depth from the groundwater. Approximately 150,000 cy of structural fill was placed in 6-inch lifts and compacted to  $\geq 95\%$  of the maximum standard Proctor dry density and within -3% to +3% of the standard Proctor optimum water content. Following subgrade preparation, a 2-ft thick clay liner was placed and compacted in 6-inch thick lifts to 95% of the maximum standard Proctor dry density and within +2% to

+6% of the standard Proctor optimum water content. Based on testing of Shelby tube samples collected during clay liner construction, the compacted clay liner has a hydraulic conductivity less than  $1 \times 10^{-7}$  cm/s. A 60-mil HDPE geomembrane was placed over the clay liner and subsequently covered with a 1-ft thick soil cover.

In 2015, repairs were made to the protective cover along the inside crest of the embankment.

### **3.5.1.3 FGD-C Pond**

Following removal of loose/soft and/or organic material, the FGD-C embankment was constructed of compacted site soils placed in 6-inch lifts compacted to  $\geq 95\%$  of the standard Proctor maximum dry density and within -3% to +3% of the standard Proctor optimum water content.

FGD-C Pond is lined with a composite liner consisting of a 2-ft thick clay liner, a 60-mil HDPE geomembrane and a 2-ft thick soil/ash protective cover. The clay liner was placed and compacted in 6-inch thick lifts to  $\geq 95\%$  of the maximum standard Proctor dry density and within +2% to +6% of the standard Proctor optimum water content. Based on testing of Shelby tube samples collected during clay liner construction, the compacted clay liner has a hydraulic conductivity less than  $1 \times 10^{-7}$  cm/s.

### **3.5.2 Construction Dates**

The following is a list of the Oak Grove FGD-A, FGD-B, and FGD-C Ponds' construction dates.

- Circa 1980: Site grading, structural fill placement, and soil liner placement at FGD-A and FGD-B Ponds.
- August 28, 2008 - October 18, 2008: Construction of the FGD-A Pond clay liner system.
- July 7, 2011 – July 25, 2011: Site grading and structural fill placement for FGD-B Pond.
- October 7, 2011 - November 9, 2011: Construction of the FGD-B Pond composite liner system.
- July 12, 2015 – August 20, 2015: Site grading and structural fill placement for FGD-C Pond.
- August 21, 2015 – February 10, 2016: Construction of the FGD-C Pond composite liner system.
- April 1, 2016 – June 24, 2016: Placement of the ash protective cover layer.

### **3.6 Drawings - §257.73(c)(1)(vii)**

Attachment 1 provides the design drawings from the FGD-A, FGD-B, and FGD-C Pond Registration Packages as well as the as-built drawings submitted within each impoundment's Liner Evaluation Report.

In each pond the normal operating pool surface and maximum depth of CCR elevation is 2 feet below the crest elevation and the maximum pool surface is equal to the embankment crest elevation. The depths of CCR are 25.5 feet in FGD-A; 13.5 feet in FGD-B; and 19.0 feet in FGD-C.

### **3.7 Instrumentation - §257.73(c)(1)(viii)**

With the exception of pool elevation gauges, there is no instrumentation on any of the surface impoundments.

### **3.8 Area-Capacity Curves - §257.73(c)(1)(ix)**

Using as-built survey information, area capacity curves have been developed for each FGD pond. The capacity curves calculation is included as Attachment 2.

### 3.9 Spillways and Diversion Features - §257.73(c)(1)(x)

There are no spillways on any of the surface impoundments.

### 3.10 Construction Specifications and Surveillance - §257.73(c)(1)(xi)

The following tables list documents that contain the design, figures, specifications, construction and quality assurance reports for the FGD Ponds.

**Table 1 - FGD-A Construction Documentation**

Document Category	Reference
TCEQ Registration Package	Pastor, Behling & Wheeler, LLC Consulting Engineers and Scientists (PBW), August 2008; TCEQ Registration Package Oak Grove Steam Electric Station FGD-A Pond.
Engineering Drawings and Technical Specifications	Fluor, August 2008; Oak Grove Power Plant, "Issued for Construction" Drawings.  Fluor, 2008; Contract Documents, FGD Impoundment Construction Specifications
Construction Quality Assurance	Fluor, 2008; Contractors Quality Assurance/Quality Control Plan, Oak Grove Project, Waste Containment Units, FGD Impoundment.
Quality Assurance Report	Golder, November 2008; FGD Pond Soil Liner Evaluation Report.

**Table 2 - FGD-B Construction Documentation**

Document Category	Document Reference
Technical Specifications	Burns and McDonnell, March 2011; Refurbished FGD-B Pond, Oak Grove Electric Station FGD-B Pond.
Update to Registration Package	Golder, October 2011; FGD-B Effluent Pond Notice of Registration Revision.
Construction Drawings	Golder, September 2011; Oak Grove Steam Electric Station FGD-B Pond Robertson County, Texas.
Construction Quality Assurance	Golder, March 2011; Soil Liner Quality Control Plan (Oak Grove Steam Electric Station).  Golder, October 2011; Geomembrane Liner Quality Control Plan (Oak Grove Steam Electric Station).
Quality Assurance Report	Golder, January 2012; Liner Evaluation Report, Oak Grove SES, FGD-B Pond.



**Table 3 - FGD-C Construction Documentation**

Document Category	Document Reference
TCEQ Registration Package	Golder, June 2015; TCEQ Registration Package Oak Grove Steam Electric Station FGD-C Pond.
Construction Drawings	Golder, April 2015; Oak Grove Steam Electric Station, FGD-C Pond, Robertson County, Texas.
Specifications and Contract Documents	Golder, April 2015; Specifications and Contract Documents For Construction of FGD-C Pond, Oak Grove Steam Electric Station.
Quality Assurance Report	Golder, October 2016; FGD-C Pond Liner Evaluation Report.

Each surface impoundment is inspected weekly by Luminant personnel and annually by a licensed professional engineer in accordance with §257.83. Items requiring maintenance and repair are identified during the inspections and subsequently repaired.

### 3.11 Structural Instability - §257.73(c)(1)(xii)

There is no knowledge of structural instability within any of the surface impoundments.

## 4.0 CLOSING

Golder Associates was retained by Luminant to prepare a history of construction for the CCR units at the Oak Grove SES. Based on our review of the available information, to the extent feasible, this letter provides information required by 40 CFR §257.73(c)(i) through (xii), related to construction of FGD-A, FGD-B, and FGD-C Ponds.

Sincerely,

**GOLDER ASSOCIATES INC.**



Varenya Kumar  
Staff Geotechnical Engineer

VK/JBF/kc



Jeffrey B. Fassett, PE  
Senior Consultant and Associate

Golder Associates Inc.  
Firm Registration Number F-2578

Attachments or Enclosures:


Figure 1 – Topographic Map  
Figure 2 – General Site Map

Attachment 1 – Design Drawings  
Attachment 2 – Area Capacity Curves

## 5.0 REFERENCES:

- Fluor Enterprises, Inc. (May 2008). Soil Liners and Cover Systems (Rev. 0). Robertson County, TX.
- Pastor, Behling & Wheeler, LLC Consulting Engineers and Scientists (August 2008). TCEQ Registration Package Oak Grove Steam Electric Station FGD-A Pond.
- Golder Associates Inc. (October 2008). Oak Grove SES FGD Pond Subsurface Investigation.
- Golder Associates Inc. (November 2008). FGD Pond Soil Liner Evaluation Report.
- Golder Associates Inc. (May 2010). FGD Pond Existing Liner Evaluation.
- Burns and McDonnell, (March 2011) Refurbished FGD-B Pond, Oak Grove Electric Station FGD-B Pond.
- Golder Associates Inc. (March 2011). Soil Liner Quality Control Plan (Oak Grove Steam Electric Station).
- Golder Associates Inc. (March 2011). FGD-A Slope Stability Evaluation Report.
- Golder Associates Inc. (October 2011). Geomembrane Liner Quality Control Plan (Oak Grove Steam Electric Station).
- Golder Associates Inc. (January 2012). Liner Evaluation Report, Oak Grove SES, FGD-B Pond.
- Golder Associates Inc. (March 2014). Addendum to Slope Stability Investigation Reports.
- O'Brien & Gere Engineers, Inc. (June 2014). Dam Safety Assessment of CCW Impoundments, Luminant/Oak Grove Steam Electric Station, Prepared for: US Environmental Protection Agency. Washington, DC.
- Golder Associates Inc. (August 2016). FGD-C Pond Liner Evaluation Report.
- Golder Associates Inc. (September 2016). Oak Grove SES FGD-A, FGD-B, and FGD-C Ponds Structural Stability Assessment.
- Golder Associates Inc. (September 2016). Oak Grove SES FGD-A, FGD-B, and FGD-C Ponds Safety Factor Assessment.



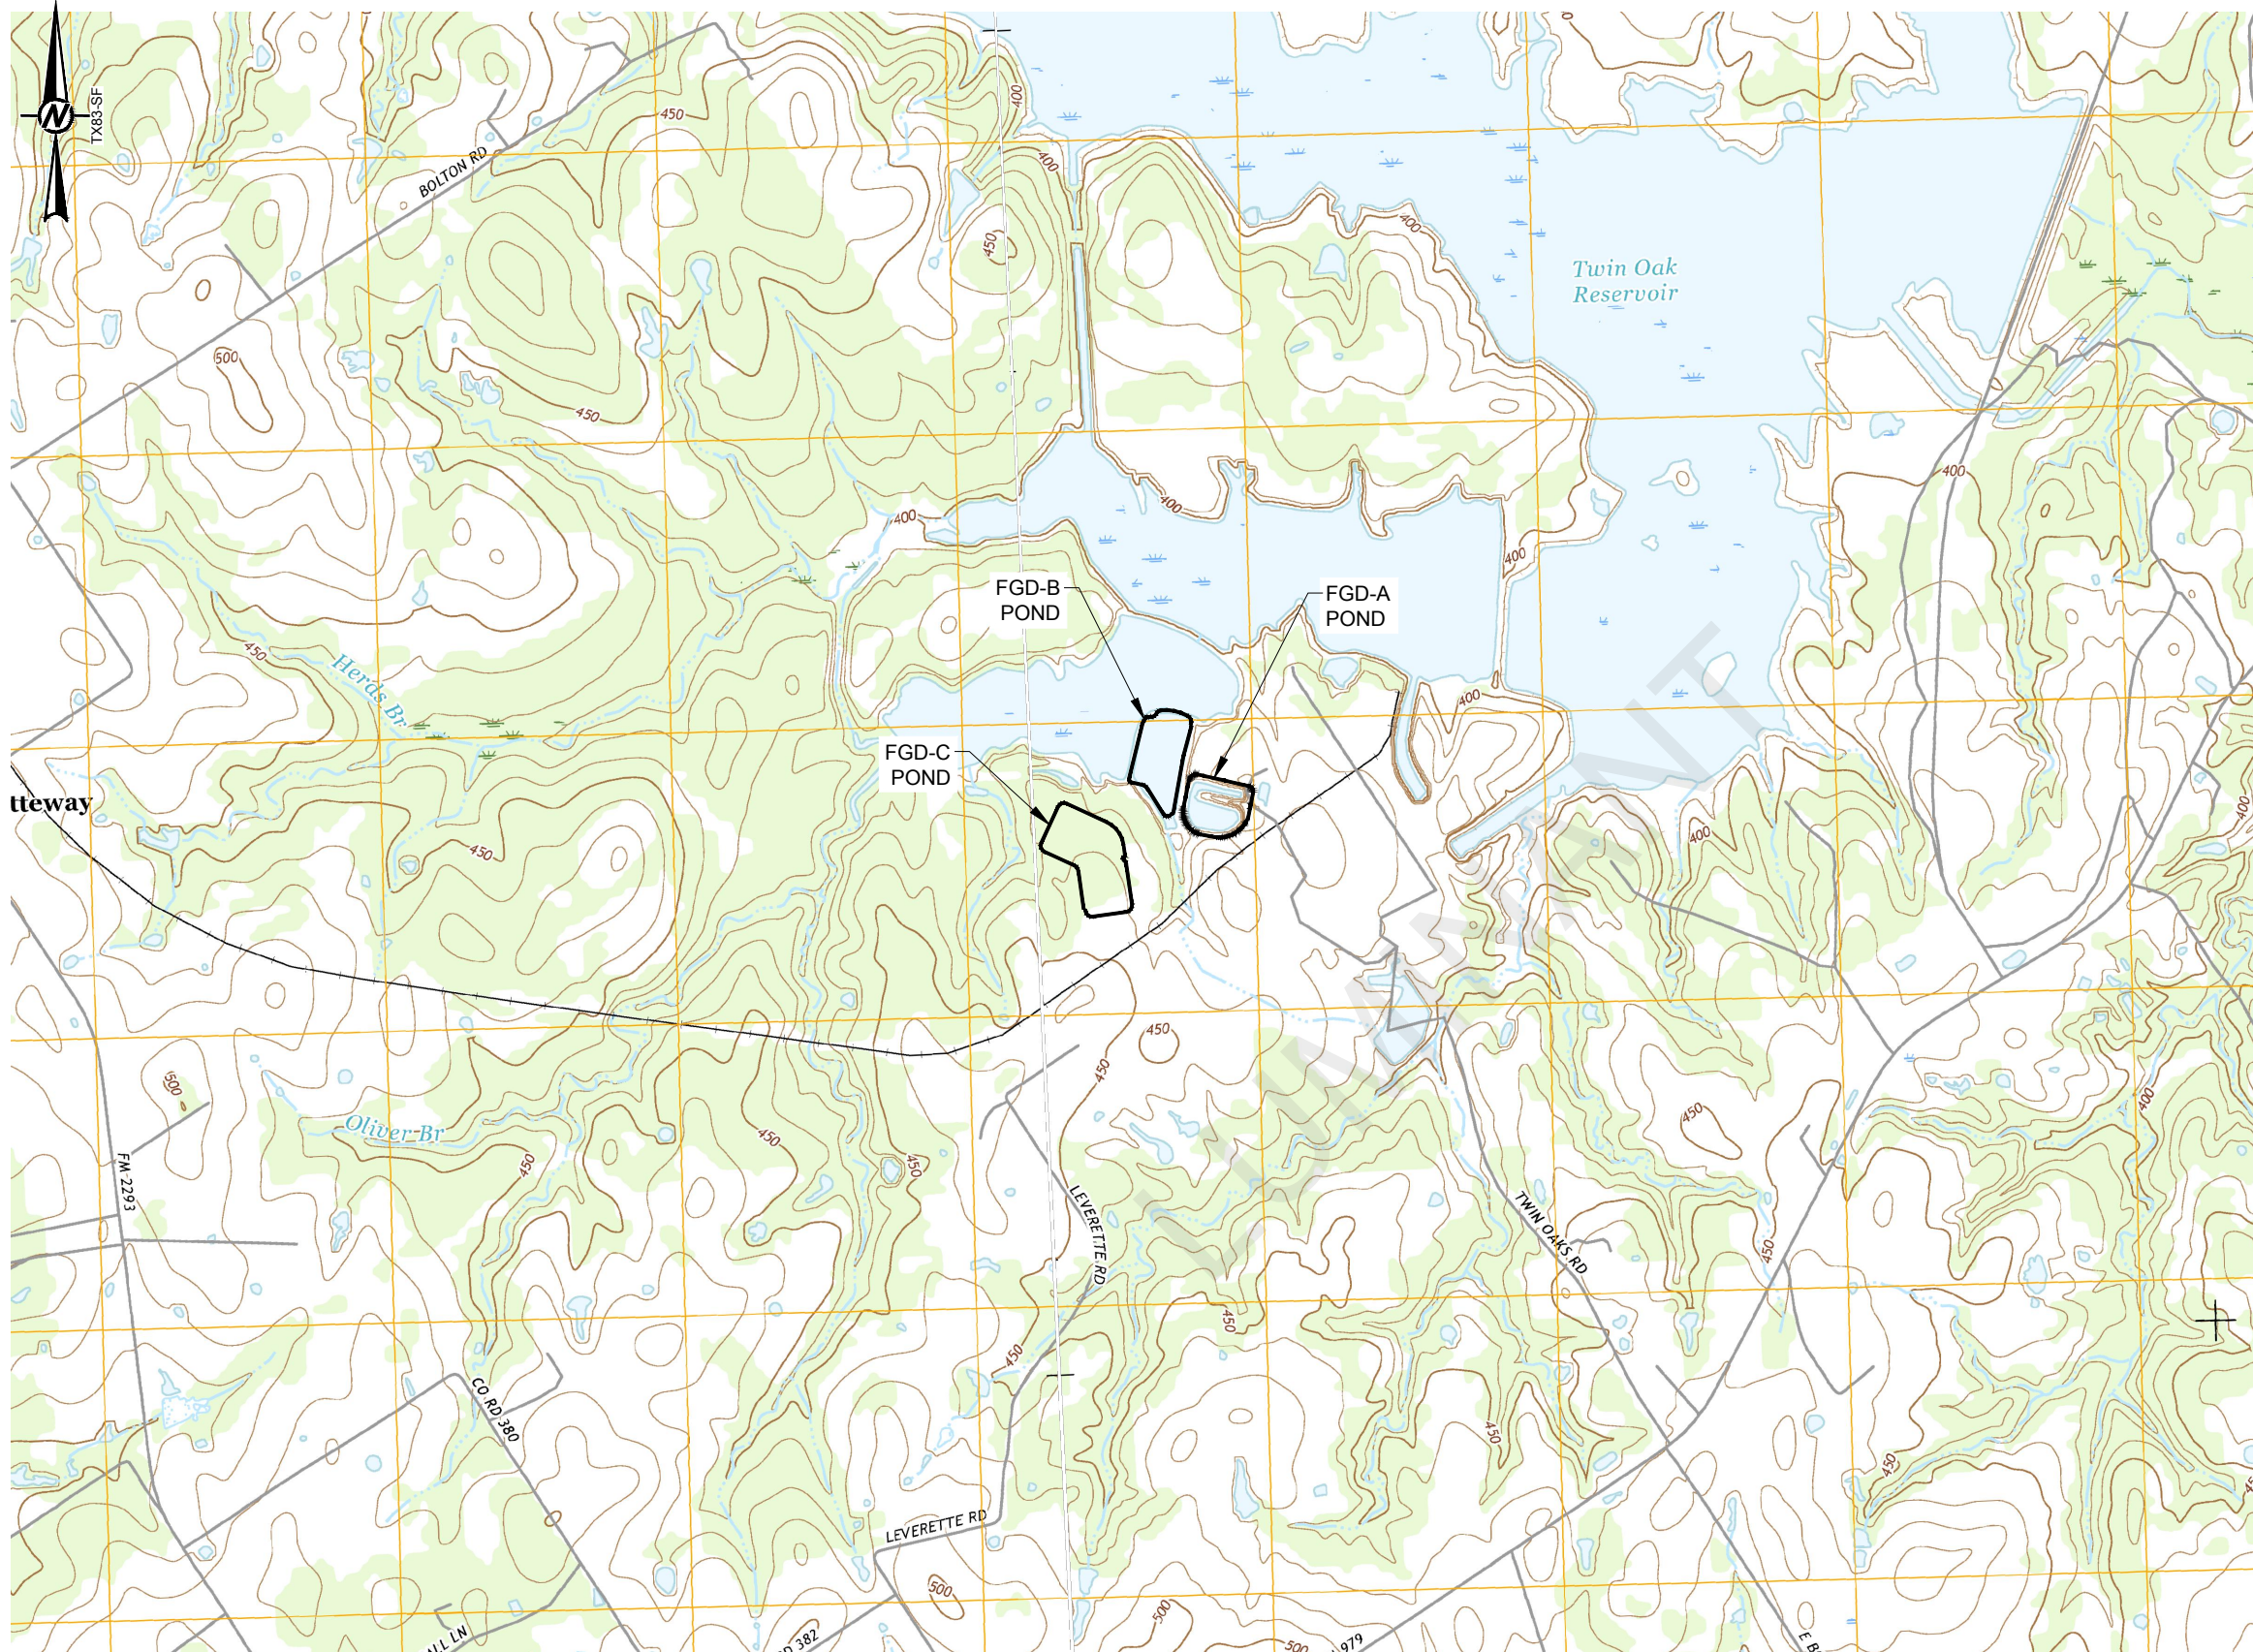

**LEGEND**

**ROAD CLASSIFICATION**

INTERSTATE ROUTE		STATE ROUTE	
US ROUTE		LOCAL ROAD	
RAMP		4WD	
Interstate Route	US Route	State Route	
MAJOR CONTOURS	550	MINOR CONTOURS	
BODY OF WATER		PERENNIAL STREAM	
WOODLAND		INTERMITTENT STREAM	


**REFERENCE**  
 BASE MAP PUBLISHED BY U.S. GEOLOGICAL SURVEY, PETTEWAY AND BALD PRAIRIE QUADRANGLES, TX. SCALE 1:24,000. 7.5 MINUTE SERIES. DATED MARCH 2016.

Path: \\boston\drafting\_2016\_1648164 - Luminant\_OakGrove\PRODUCTION\HISTORY OF CONSTRUCTION | File Name: 1648164002.dwg | Last Edited By: boston | Date: 2016-10-10 Time: 10:31:38 AM | Printed By: boston | Date: 2016-10-10 Time: 10:31:50 AM

*J.B. Fassett*  
10/10/16



Professional Engineering Firm  
 Registration Number F-2578

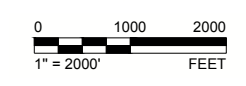

CLIENT	LUMINANT POWER OAK GROVE
CONSULTANT	
YYYY-MM-DD	2016-09-29
DESIGNED	VK
PREPARED	TNB
REVIEWED	MX
APPROVED	JBF


PROJECT	2016 COAL COMBUSTION RESIDUALS ENGINEERING SERVICES
TITLE	<b>TOPOGRAPHIC MAP</b>
PROJECT NO.	1648164
REV.	A
FIGURE	1

1 in. IF THIS MEASUREMENT DOES NOT MATCH WHAT IS SHOWN, THE SHEET SIZE HAS BEEN MODIFIED FROM ANSI B





REFERENCE(S)  
AERIAL PHOTO SOURCED FROM GOOGLE EARTH PRO DATED 2016

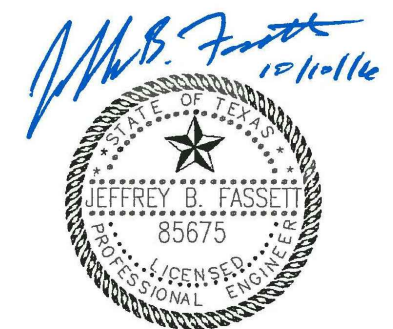

Professional Engineering Firm  
Registration Number F-2578



Path: \\bussard\cadd\2016\_1648164 - Luminant\_OakGrove\PRODUCTION\HISTORY OF CONSTRUCTION | File Name: 1648164001.dwg

CLIENT  
LUMINANT POWER  
OAK GROVE

CONSULTANT



YYYY-MM-DD	2016-09-29
DESIGNED	VK
PREPARED	TNB
REVIEWED	MX
APPROVED	JBF

PROJECT  
2016 COAL COMBUSTION RESIDUALS  
ENGINEERING SERVICES

TITLE  
**GENERAL SITE MAP**

PROJECT NO.  
1648164

REV.  
A

FIGURE  
2

1 in. IF THIS MEASUREMENT DOES NOT MATCH WHAT IS SHOWN, THE SHEET SIZE HAS BEEN MODIFIED FROM ANSI B



**ATTACHMENT 1  
DESIGN DRAWINGS**

LUMINANT


**FDG A  
DESIGN DRAWINGS**

LUMINANT



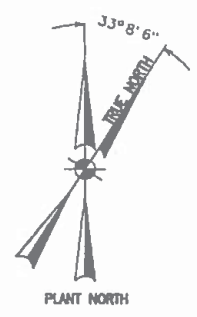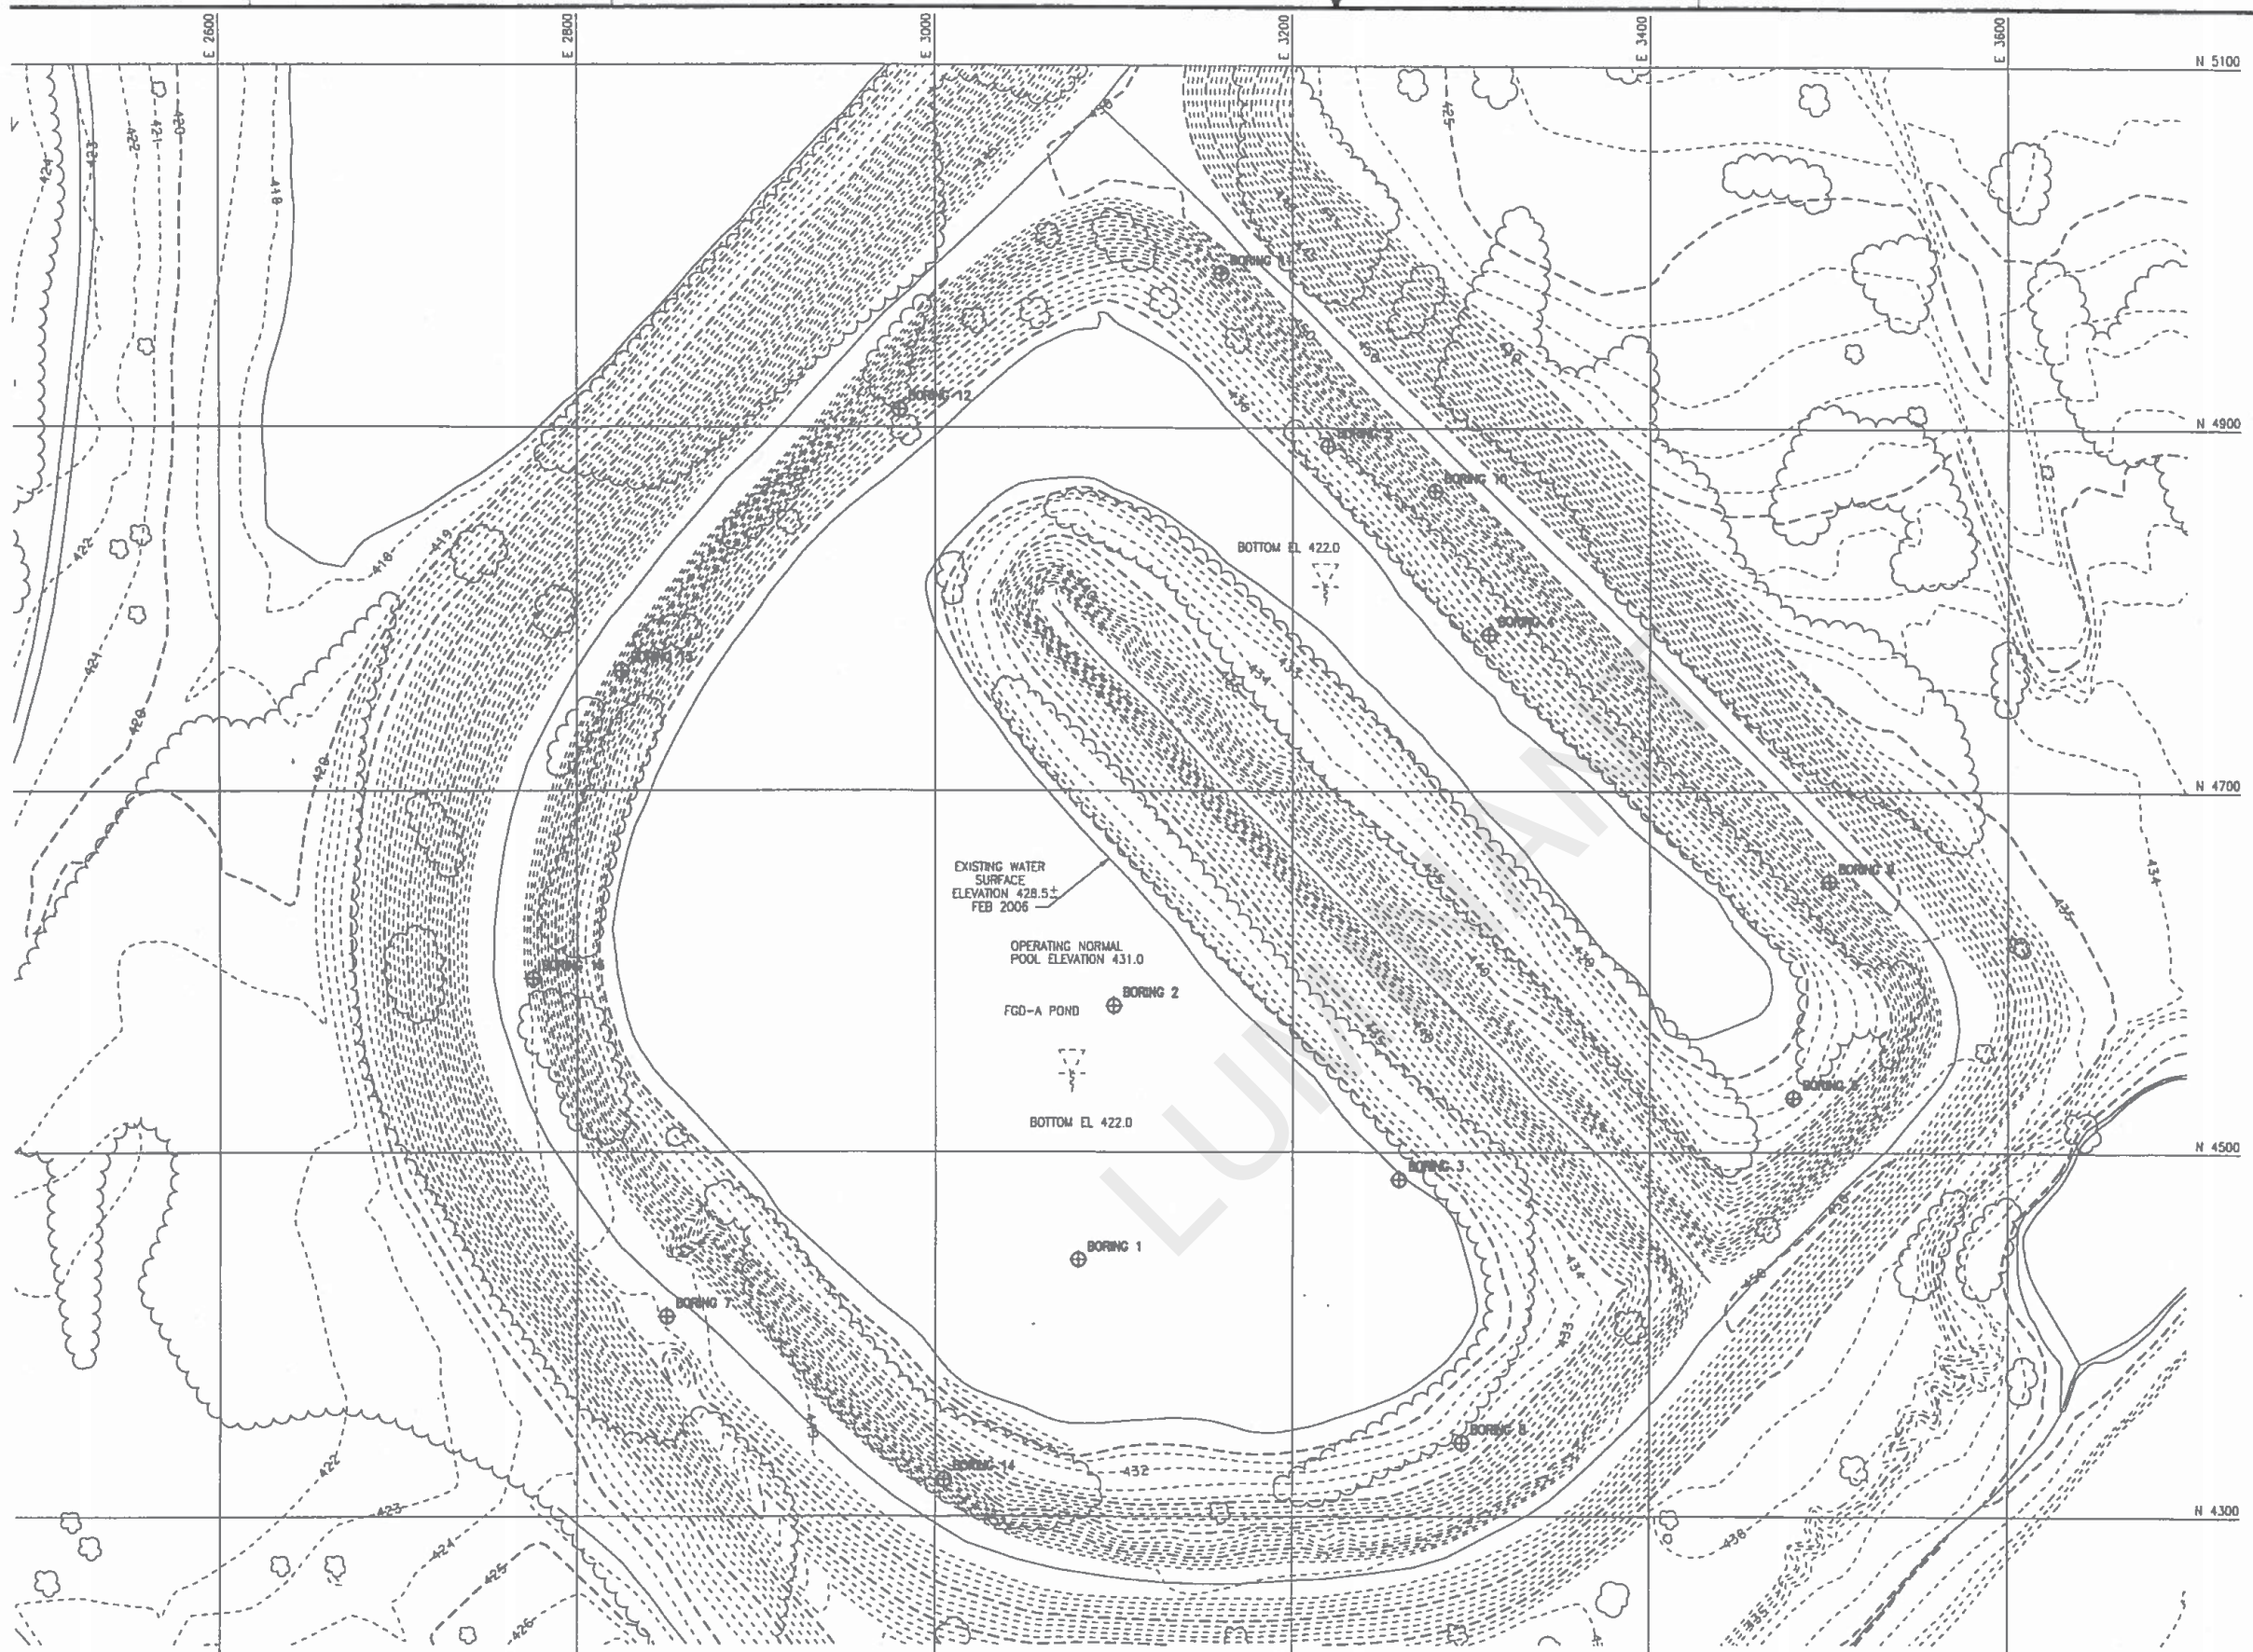

**LEGEND:**  
 ⊕ BORING 1 EXISTING BORING

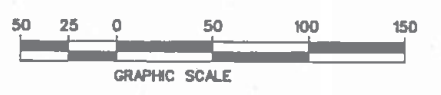

REVISION DESCRIPTION  
 YOUSLY ISSUED AS A2YF00-0-CV-0-SW-SK-04 - ISSUED FOR CONSTRUCTION

DRWN	LAY	CSA	ENGR	DWG. NO.	REFERENCE DRAWINGS
CHK	MECH	ELEC	REF.		
DF	W/C				
JC					

RESERVED FOR PROFESSIONAL ENGINEER'S SEAL, IF APPLICABLE



**FLUOR ENTERPRISES, Inc**

NOTICE: THIS DRAWING HAS NOT BEEN PUBLISHED AND IS THE SOLE PROPERTY OF FLUOR CORPORATION AND IS LOANED TO THE BORROWER FOR THEIR CONFIDENTIAL USE ONLY, AND IN CONSIDERATION OF THE LOAN OF THIS DRAWING, THE BORROWER PROMISES AND AGREES TO RETURN IT UPON REQUEST AND AGREES THAT IT SHALL NOT BE REPRODUCED, COPIED, LENT OR OTHERWISE DISPOSED OF DIRECTLY OR INDIRECTLY, NOR USED FOR ANY PURPOSE OTHER THAN FOR WHICH IT IS FURNISHED.

DESIGNED BY D.FOX	DATE 8/5/08
CHECKED BY J.GERVAS	DATE 8/5/08
APPROVED BY J. GERVAS	DATE 8-5-08
DESIGNED BY J.MELE	DATE 8-5-08
APPROVED BY J.S.A.	DATE 8/5/08
TECHNICAL DIRECTION M. S. B. / J. B. / J. B.	DATE 8/5/08



OAK GROVE MANAGEMENT COMPANY, LLC  
 OAK GROVE ELECTRIC STATION  
 ROBERTSON COUNTY, TX

FIGURE 1-1  
 FGD SCRUBBER POND  
 EXISTING BORING LOCATION PLAN

AS NOTED PROJECT NUMBER: A2YF00 LIST TO: 000 TYPE: FGD SUBJECT CODE: CF-01 SHEET NO: 02 OF 1

CONTRACT NO. 01020305060708091011121314151617181920212223242526272829303132333435363738394041424344454647484950  
 DIST. CODE



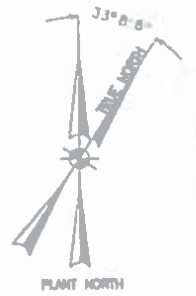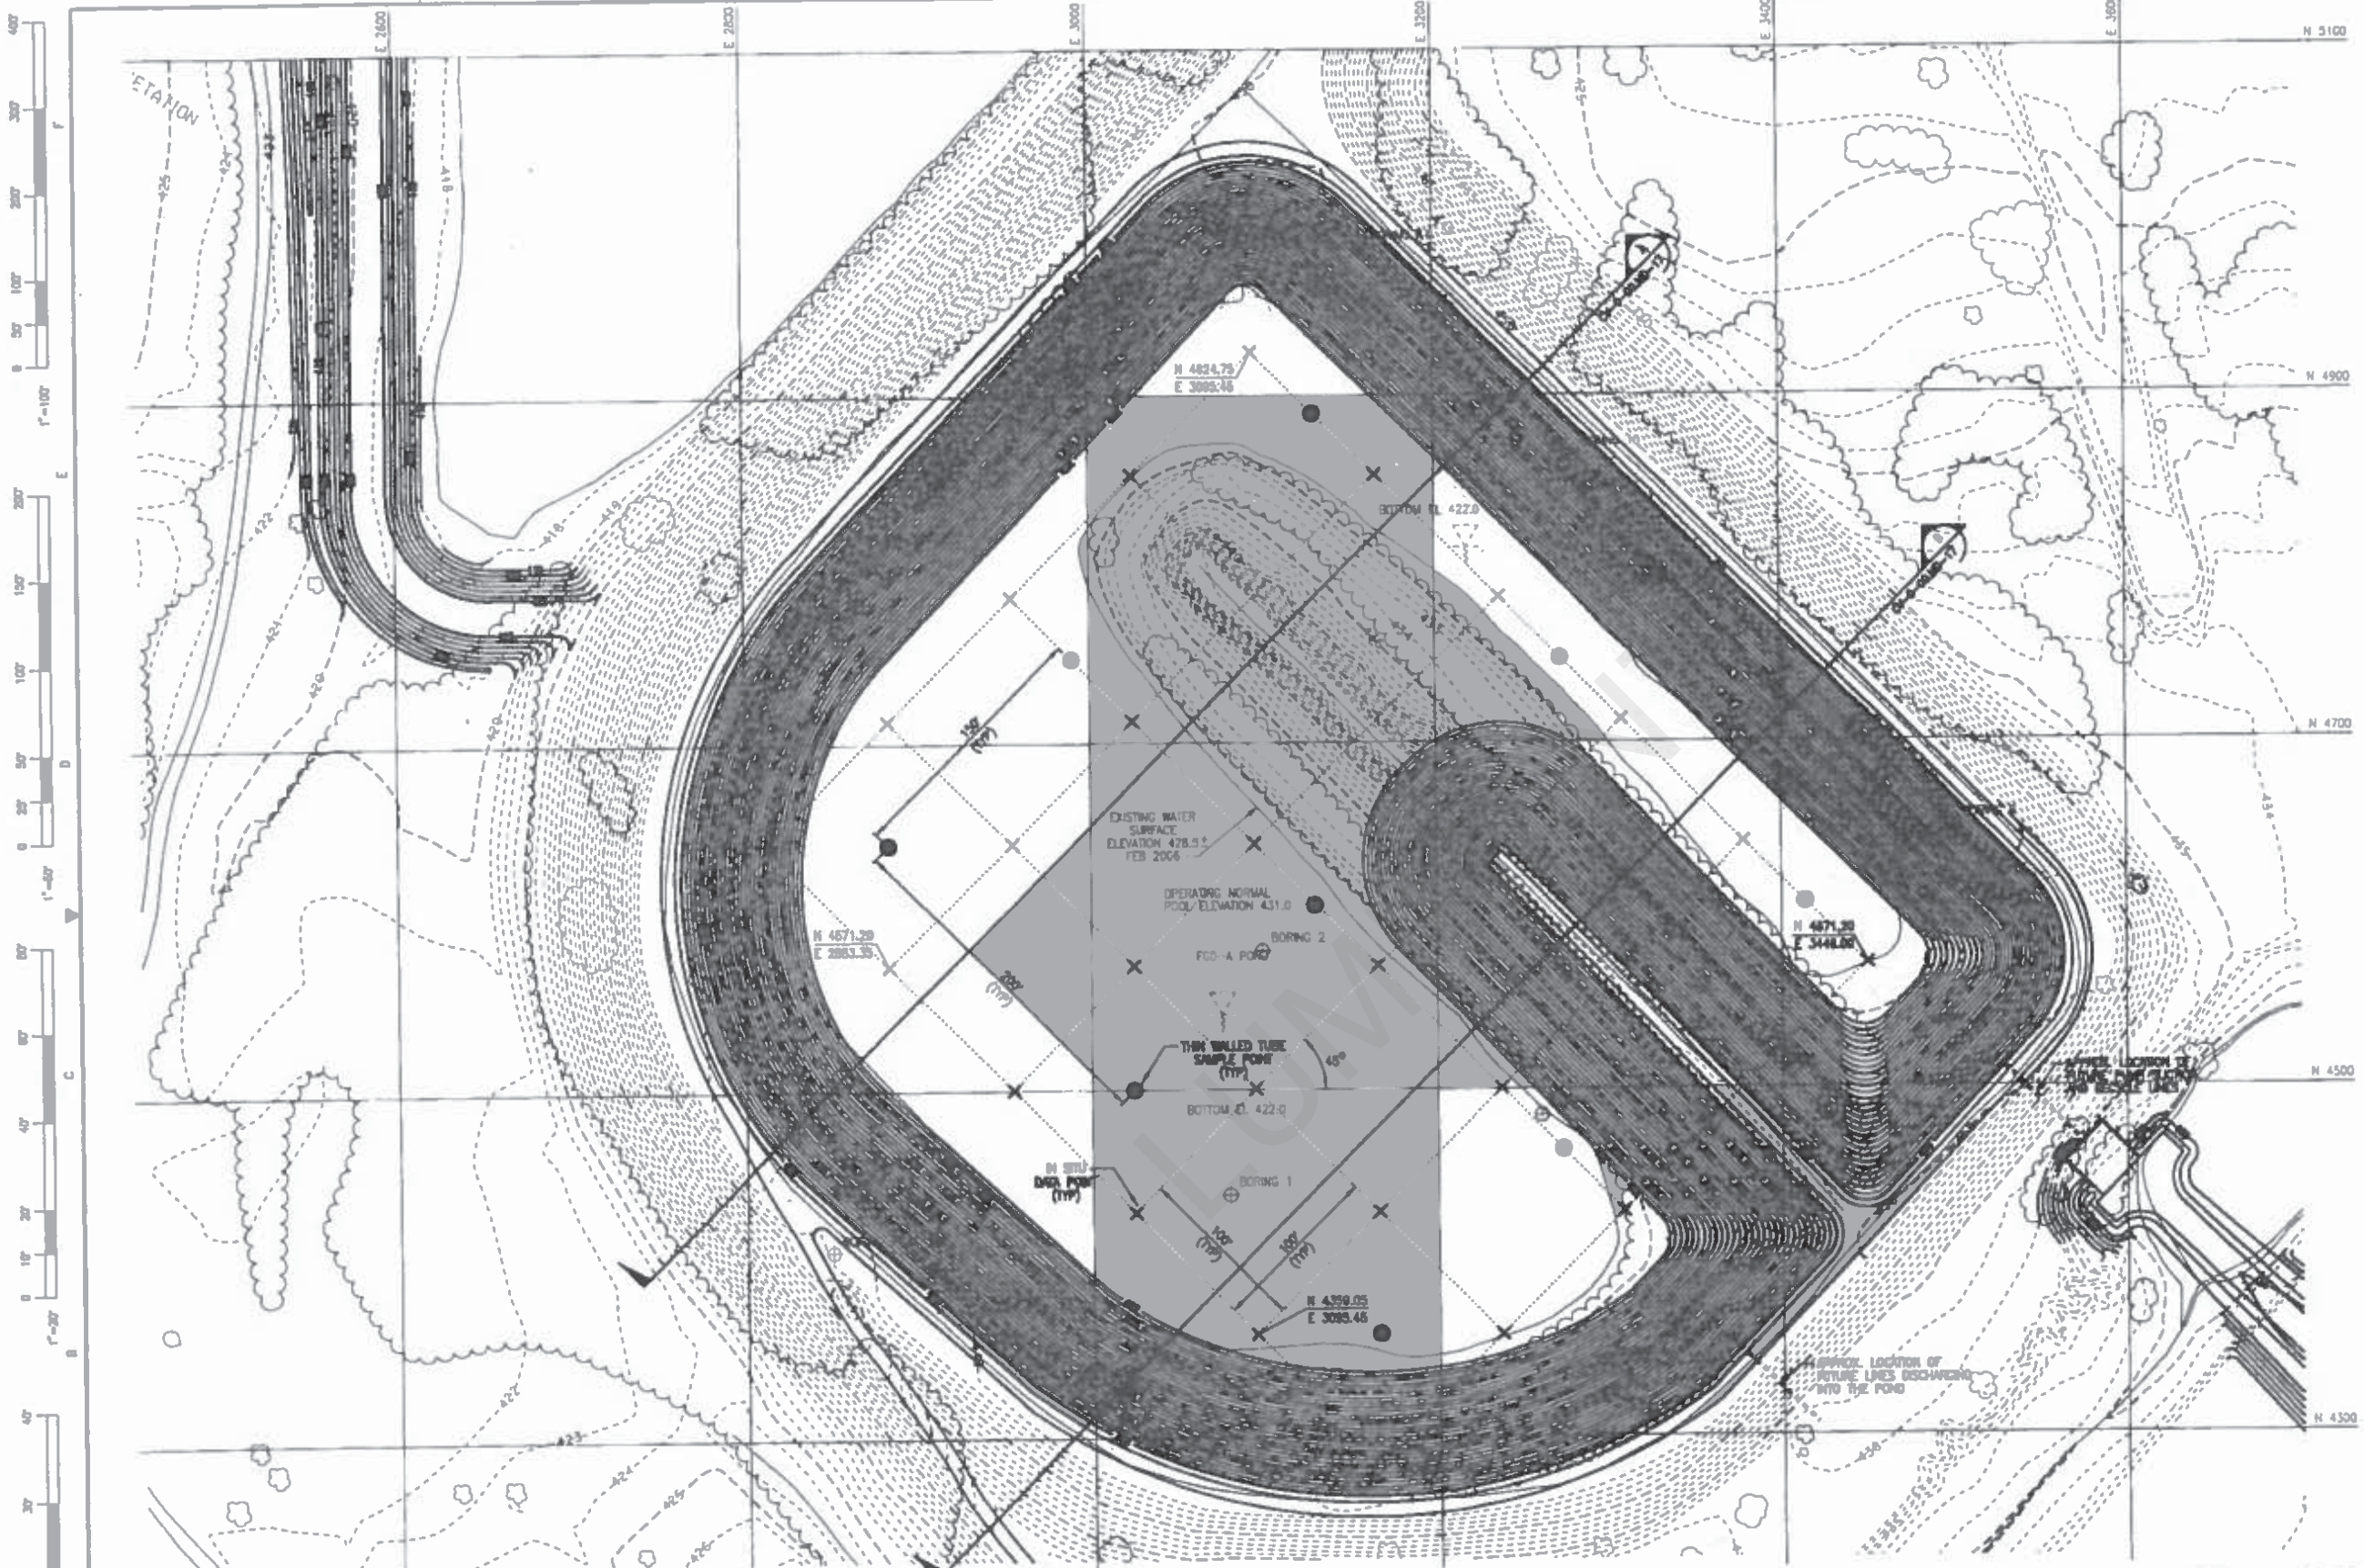

**LEGEND:**

- ⊕ BORING 1 EXISTING BORING
- + IN SITU DATA POINT (23 PLACES)
- THIN WALLED TUBE SAMPLE POINT AND BORING TO GROUNDWATER (9 PLACES)



REV.	DATE	REVISION DESCRIPTION
1	06/04/09	PREVIOUSLY ISSUED AS AZYF00-0-CV-0-03-03-03 - ISSUED FOR CONSTRUCTION

DESIGN	REFERENCE DRAWINGS	REVISIONS

REQUIRED FOR PROFESSIONAL ENGINEER'S SEAL, IF APPLICABLE

**FLUOR ENTERPRISES, Inc**

NOTICE: THIS DRAWING HAS NOT BEEN PUBLISHED AND IS THE SOLE PROPERTY OF FLUOR CORPORATION AND IS LOANED TO THE ENGINEER FOR THEIR CONFIDENTIAL USE ONLY, AND IN CONSIDERATION OF THE LOAN OF THIS DRAWING, THE ENGINEER PROMISES AND AGREES TO RETURN IT UPON REQUEST AND AGREES THAT IT SHALL NOT BE REPRODUCED, COPIED, LOANED OR OTHERWISE DISPOSED OF DIRECTLY OR INDIRECTLY, NOR USED FOR ANY PURPOSE OTHER THAN FOR WHICH IT IS PROVIDED.

DATE	BY	DESCRIPTION
06/04/09	JLD	ISSUED FOR CONSTRUCTION


**TXU**

OAK GROVE MANAGEMENT COMPANY, LLC  
OAK GROVE ELECTRIC STATION  
ROBERTSON COUNTY, TX


**FIGURE 2-1**  
FGD SCRUBBER POND  
LINER VERIFICATION SAMPLING PLAN

SCALE: AS NOTED  
PROJECT NUMBER: AZYF00-0-CV-0-03-03-03  
DRAWING NUMBER: CF-01  
SHEET NUMBER: 03-1



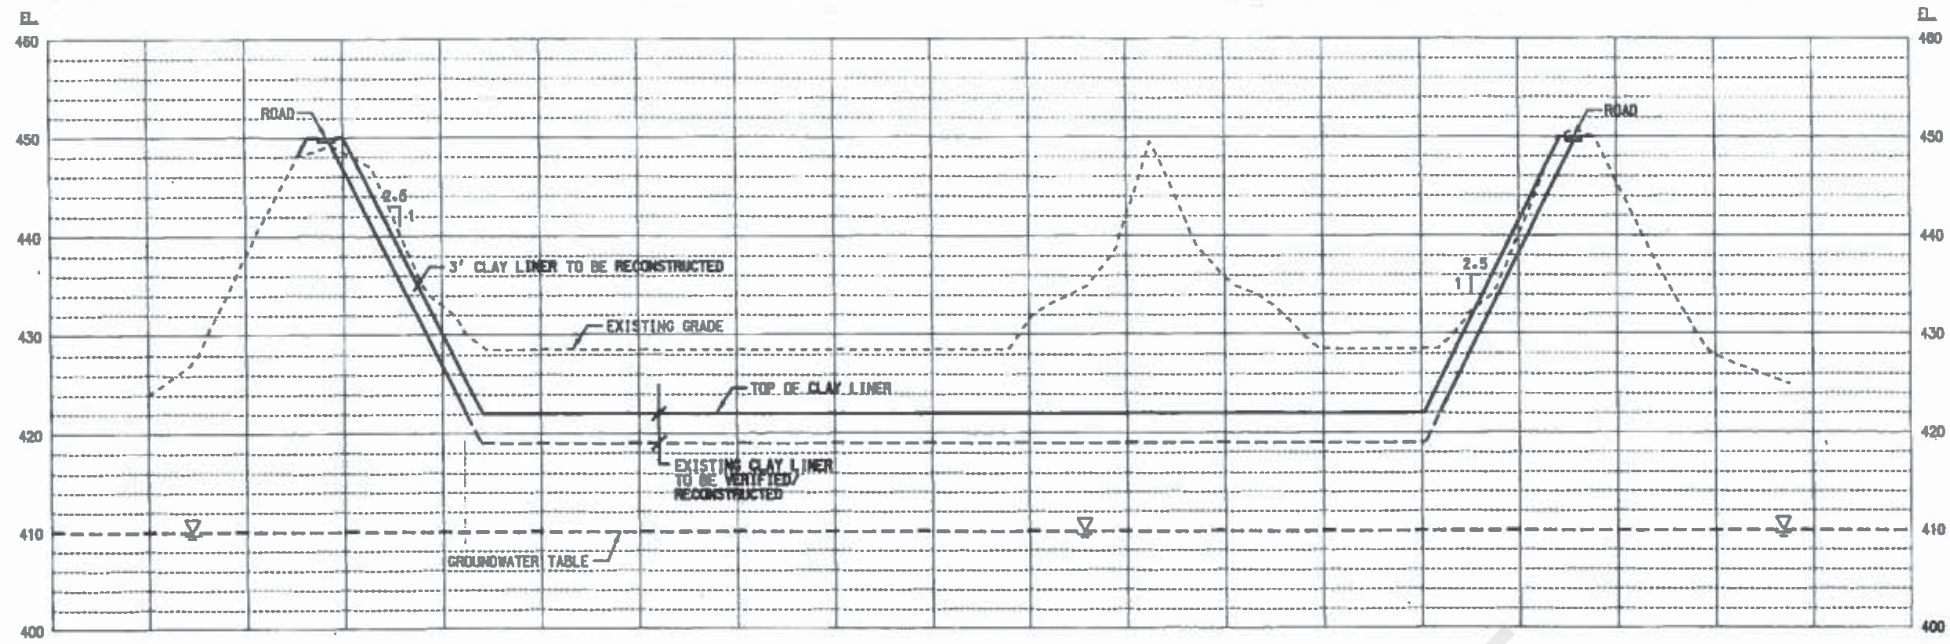

SECTION **A**  
 SCALE: 1"=50' HORIZONTAL  
 1"=10' VERTICAL  
 CY-0-CF-01-03

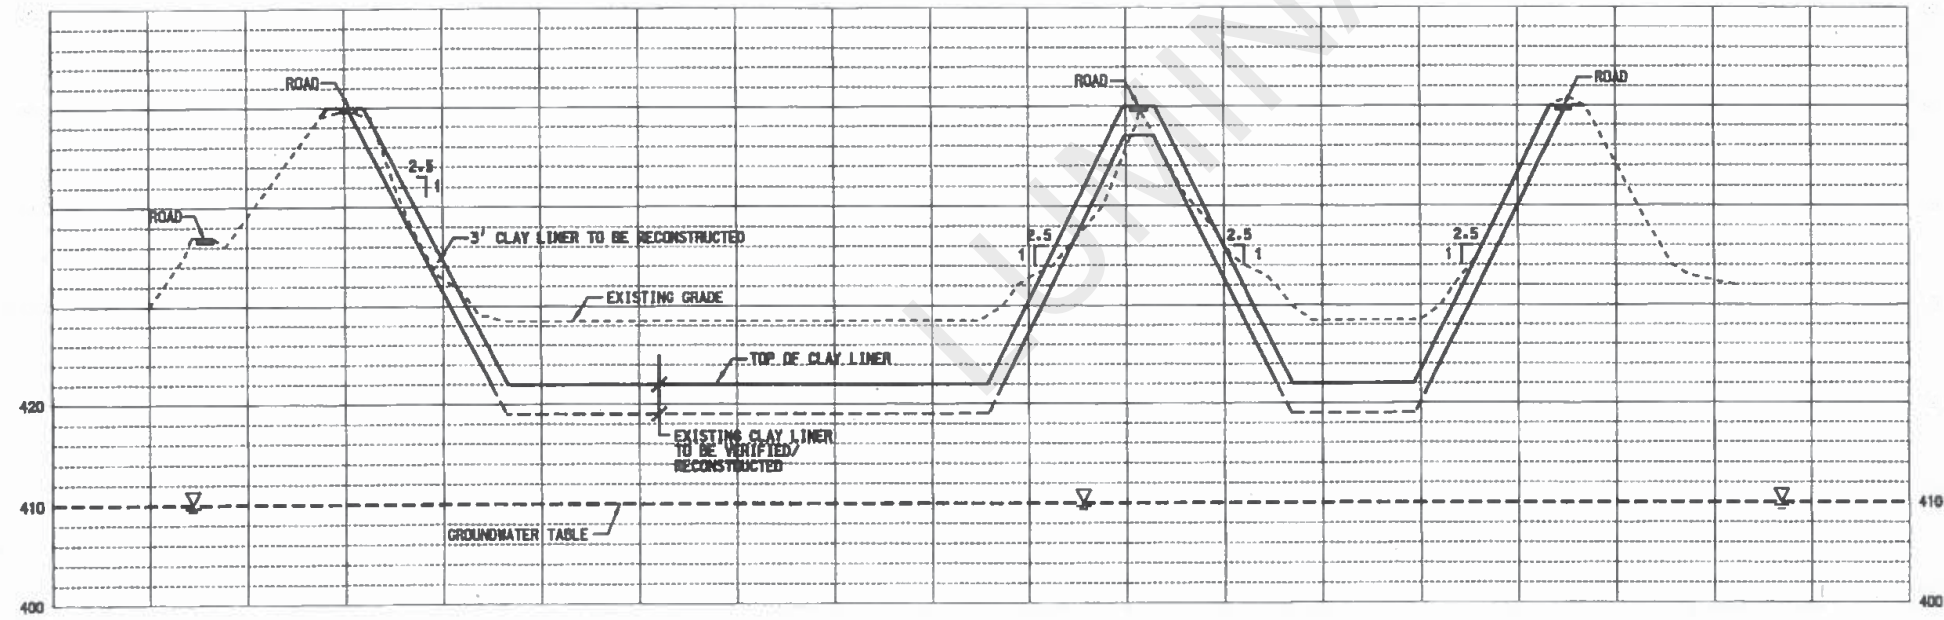

SECTION **B**  
 SCALE: 1"=50' HORIZONTAL  
 1"=10' VERTICAL  
 CY-0-CF-01-03

DRWN	LAYO	CSA	ENGR	DWG. NO.	REFERENCE DRAWINGS	RESERVED FOR PROFESSIONAL ENGINEER'S SEAL, IF APPLICABLE
CHK.	MECH	ELEC	REF.			
JD	W	W	W			

DRWN	LAYO	CSA	ENGR	DWG. NO.	REFERENCE DRAWINGS	RESERVED FOR PROFESSIONAL ENGINEER'S SEAL, IF APPLICABLE
CHK.	MECH	ELEC	REF.			

RESERVED FOR PROFESSIONAL ENGINEER'S SEAL, IF APPLICABLE



**FLUOR ENTERPRISES, Inc**

NOTICE: THIS DRAWING HAS NOT BEEN PUBLISHED AND IS THE SOLE PROPERTY OF FLUOR CORPORATION AND IS LOANED TO THE BORROWER FOR THEIR CONFIDENTIAL USE ONLY, AND IN CONSIDERATION OF THE LOAN OF THIS DRAWING, THE BORROWER PROMISES AND AGREES TO RETURN IT UPON REQUEST AND AGREES THAT IT SHALL NOT BE REPRODUCED, COPIED, LENT OR OTHERWISE DISPOSED OF DIRECTLY OR INDIRECTLY, NOR USED FOR ANY PURPOSE OTHER THAN FOR WHICH IT IS FURNISHED.

DESIGNED BY D.FOX	DATE/DATE 08/15/08
CHECKED BY J.GERVAIS	DATE/DATE 08/15/08
APPROVED BY OWNER J. Gervais	DATE/DATE 08/15/08
APPROVED BY ENGINEER J. Wells	DATE/DATE 08/15/08
APPROVED BY ECA J. Wells	DATE/DATE 08/15/08
APPROVED BY FLUOR J. Wells	DATE/DATE 08/15/08
APPROVED BY MWH M. Wells	DATE/DATE 08/15/08

OAK GROVE MANAGEMENT COMPANY, LLC  
 OAK GROVE ELECTRIC STATION  
 ROBERTSON COUNTY, TX

FGD SCRUBBER POND  
 CROSS SECTIONS

SCALE	PROJECT NUMBER	UNIT No	DOC TYPE	PLANT	SUBJECT CODE	ISS. No	REV.
AS NOTED	A2YF00	0	CV	00	MD	17	1

CONTRACT PRG. 10'  
 0' 1' 2' 3' 4' 5'  
 10'  
 20'  
 30'  
 1000'

**FDG B  
DESIGN DRAWINGS**

LUMINANT















Drawing File: J:\\_2011\113-94788 - Oak Grove LC - FGD Pond Option 3 \ 11394788C006.dwg | Layout: ANSI Full Bleed B (11.00 X 17.00 Inches) | Modified: 9/21/2011 3:20:26 PM VEstrada | Plotted: Wednesday, September 21, 2011 3:21:05 PM VEstrada

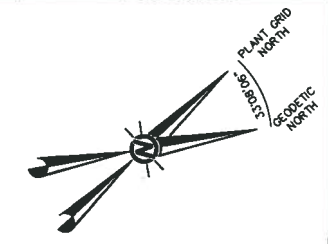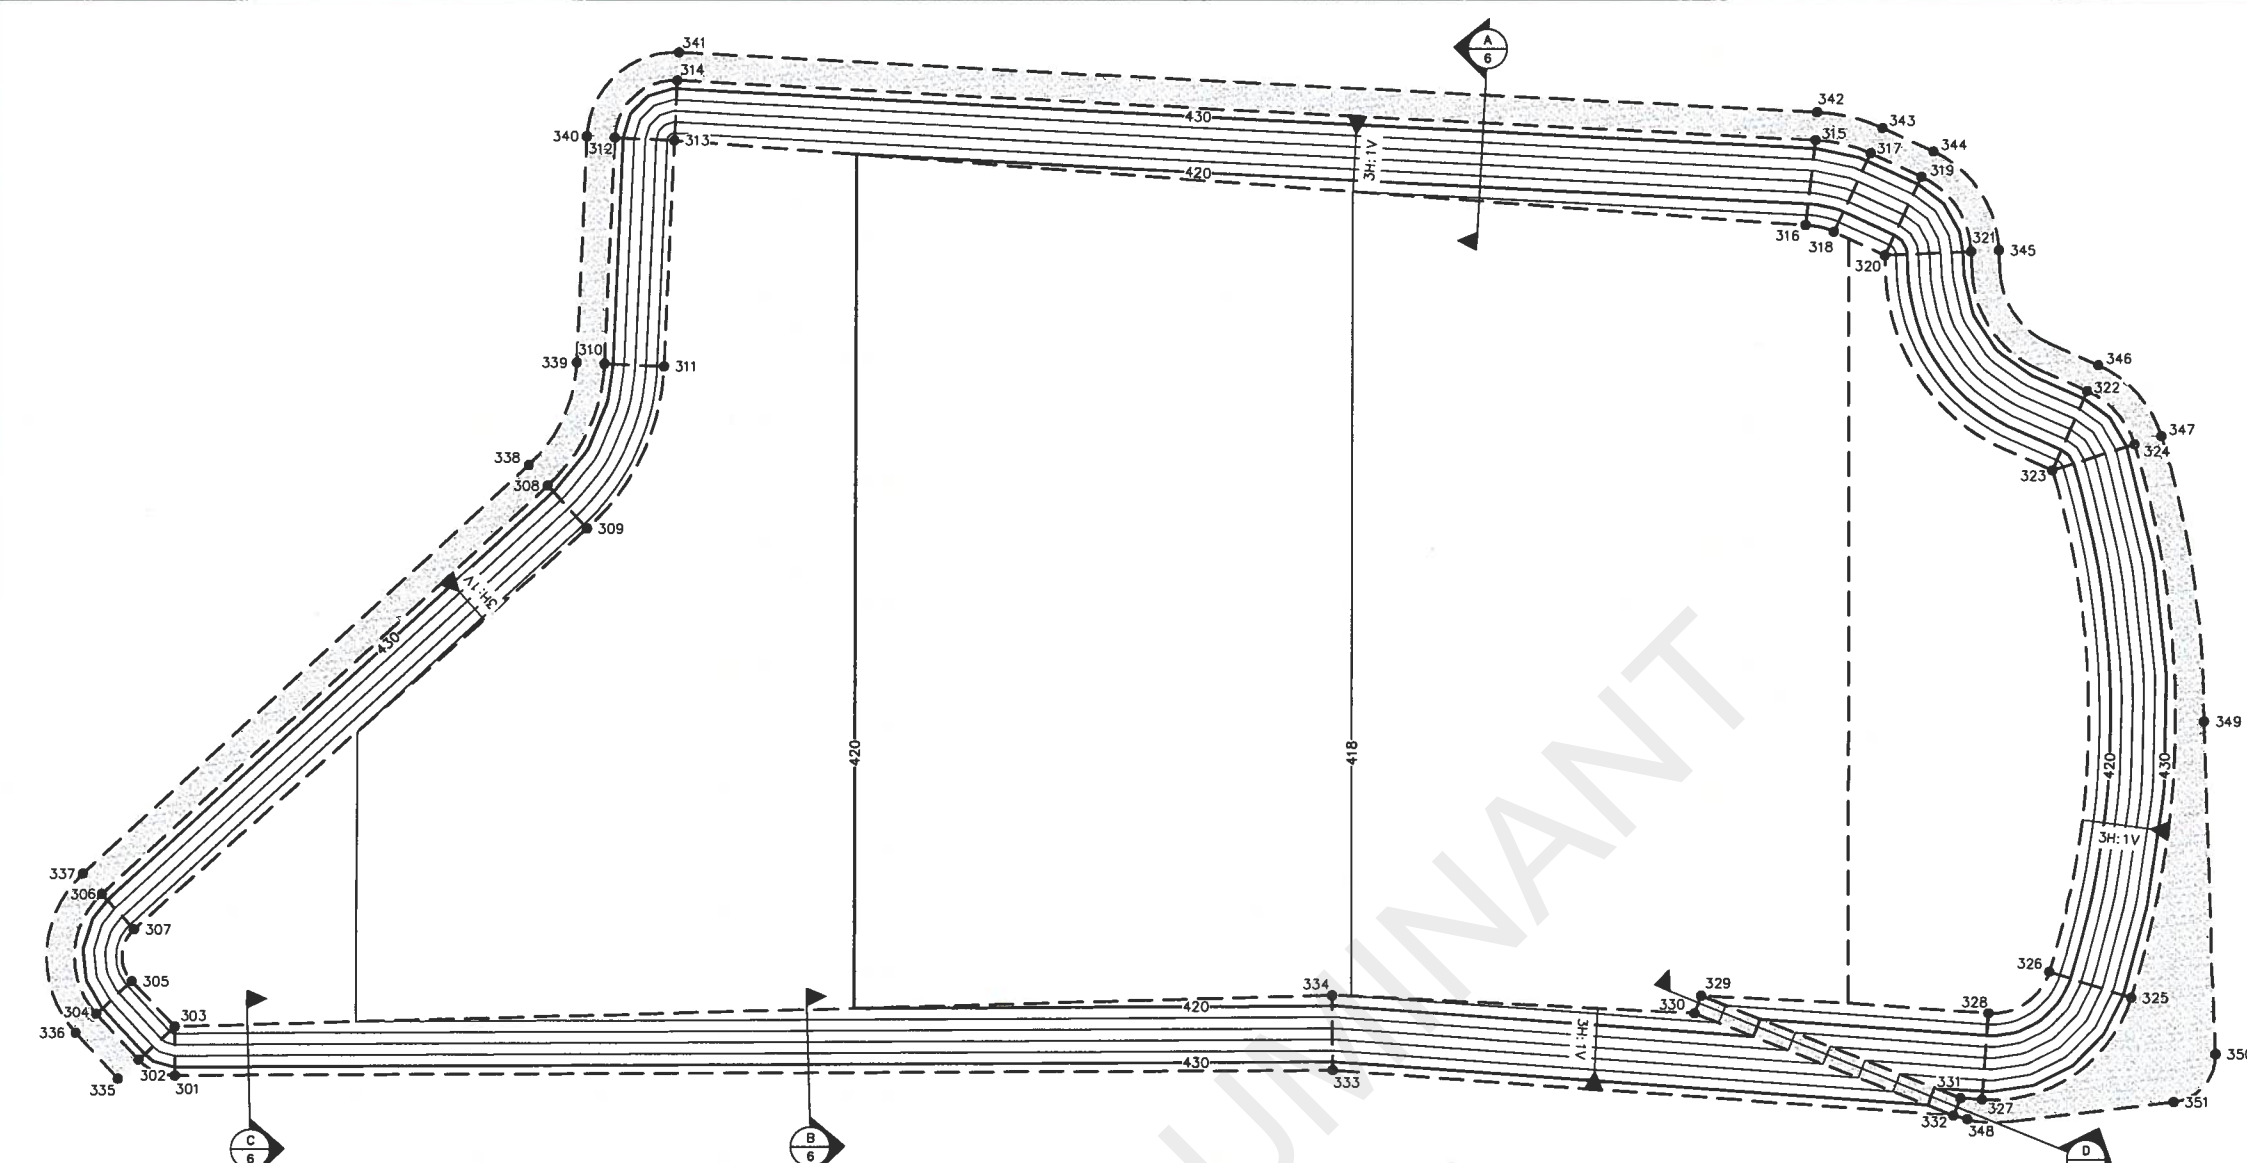

**LEGEND**

- 430 — PROTECTIVE COVER CONTOUR
- - - PROTECTIVE COVER GRADE BREAK
- 301 PROTECTIVE COVER CONTROL POINT

**NOTES**

1. CONTOURS SHOWN ARE FOR TOP OF PROTECTIVE COVER OF FGD - B POND.

PROTECTIVE COVER CONTROL POINTS			
Point No.	Northing	Easting	Elevation
301	4808.03	2708.01	431.50
302	4799.50	2688.69	431.50
303	4825.82	2688.61	422.73
304	4799.50	2655.00	431.50
305	4825.30	2655.00	422.90
306	4845.00	2609.50	431.50
307	4845.00	2635.32	422.89
308	5168.67	2609.50	431.50
309	5168.67	2640.76	421.08
310	5235.20	2581.95	431.50
311	5257.96	2604.71	420.77
312	5321.15	2496.00	431.50
313	5343.87	2518.96	420.73
314	5366.87	2496.28	431.50
315	5794.63	2934.45	431.50
316	5759.76	2964.55	416.17
317	5811.27	2959.67	431.50
318	5768.48	2977.40	416.06
319	5822.75	2987.38	431.50
320	5779.75	3005.09	416.00

PROTECTIVE COVER CONTROL POINTS			
Point No.	Northing	Easting	Elevation
321	5815.28	3035.09	431.50
322	5810.66	3132.76	431.50
323	5768.01	3151.27	416.00
324	5809.99	3171.27	431.50
325	5607.51	3388.72	431.50
326	5584.52	3348.30	416.00
327	5511.31	3374.11	0.00
328	5545.27	3342.35	416.00
329	5438.82	3231.16	416.59
330	5429.92	3235.72	416.61
331	5503.35	3365.60	431.50
332	5494.33	3369.93	431.50
333	5266.17	3126.07	431.50
334	5293.11	3096.36	418.13
335	4784.50	2688.69	431.50
336	4784.50	2655.00	431.50
337	4845.00	2594.50	431.50
338	5168.67	2594.50	431.50
339	5224.59	2571.34	431.50
340	5310.54	2485.39	431.50

PROTECTIVE COVER CONTROL POINTS			
Point No.	Northing	Easting	Elevation
341	5377.60	2485.80	431.50
342	5805.37	2923.98	431.50
343	5825.12	2953.92	431.50
344	5836.61	2981.63	431.50
345	5826.72	3044.79	431.50
346	5824.41	3126.76	431.50
347	5823.52	3177.74	431.50
348	5498.35	3376.49	431.50

REV	DATE	DES	CHK	RW

GOLDER ASSOCIATES INC.  
F-2578

---

**PROJECT**

LUMINANT  
FGD - B POND CONSTRUCTION  
ROBERTSON COUNTY, TEXAS

---

**TITLE**

**PROTECTIVE COVER  
GRADING PLAN**

---

PROJECT No.	113-94788
FILE No.	11394788C 006
SCALE	AS SHOWN
DESIGN	CEI 08/2011
CADD	VJE 08/2011
CHECK	CFR 08/2011
REVIEW	CEI 08/2011

5

ISSUED FOR CONSTRUCTION





**FDG C  
DESIGN DRAWINGS**

LUMINANT










- LEGEND**
- 25 ft EXISTING CONTOUR
  - 5 ft EXISTING CONTOUR
  - CURRENT POND CONSTRUCTION AREA
  - FGD-C-01 BOREHOLE
  - FGD-01 MONITORING WELL

- NOTES**
1. EXISTING GROUND TOPOGRAPHY IS FROM AN AERIAL SURVEY PERFORMED BY GEODETIX, INC. ON MAY 27, 2010 AND GROUND SURVEY PERFORMED BY SAM INC. ON OCTOBER 23, 2014. EXISTING GROUND TOPOGRAPHY ELSEWHERE IS FROM FLOUR ENTERPRISE, INC. DRAWING A2YF00-0-CV-0-SW.PL.-01, AS PROVIDED BY LUMINANT. COORDINATES ARE BASED ON OAK GROVE STEAM ELECTRIC STATION PLANT GRID SYSTEM.
  2. ELEVATIONS ARE BASED ON MEAN SEA LEVEL DATUM.
  3. CLAY MATERIAL AND STRUCTURAL FILL STOCKPILE AREAS NEED TO BE CLEARED AND GRUBBED PRIOR TO STOCKPILING ACTIVITIES.

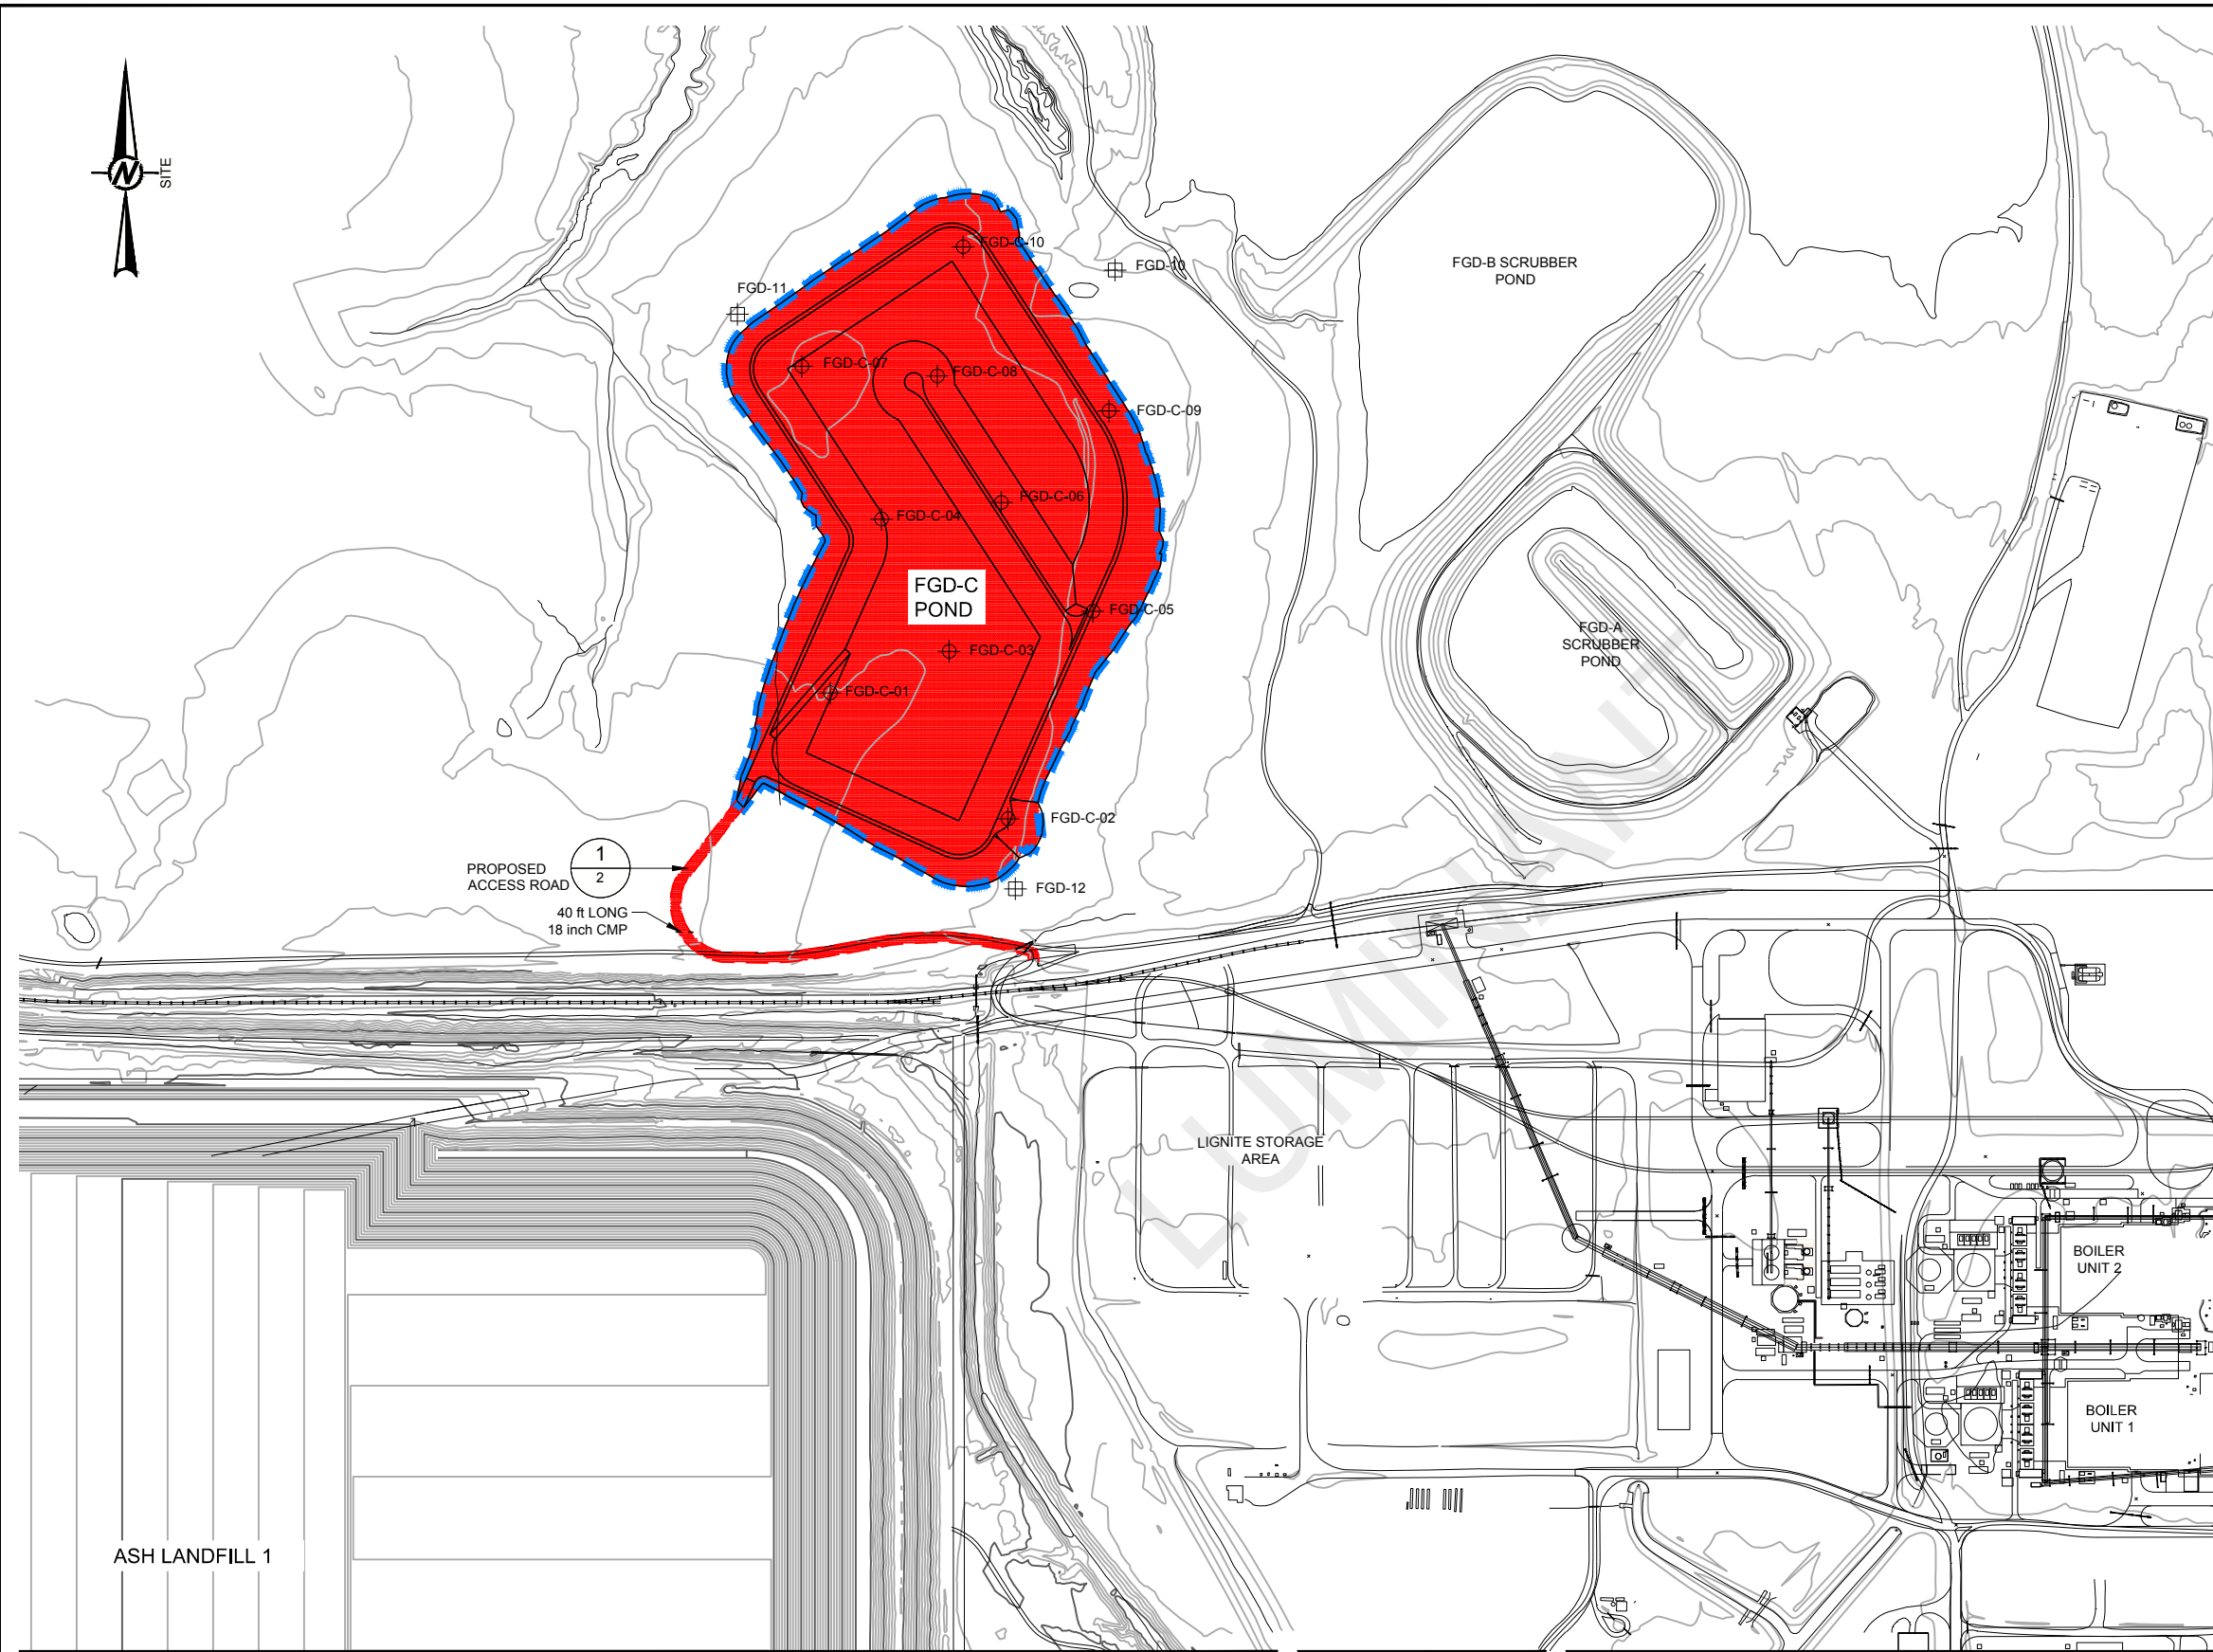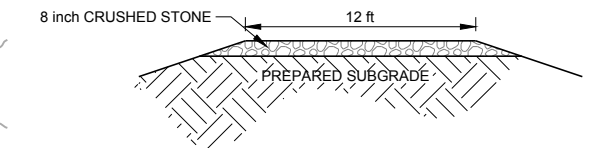

**ISSUED FOR CONSTRUCTION**

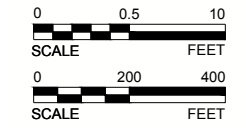

Rev.	YYYY-MM-DD	DESCRIPTION	PREPARED	DESIGN	REVIEW	APPROVED
0	2015-04-29	ISSUED FOR CONSTRUCTION	AA	CEI	CEI	JBF
B	2015-04-23	ISSUED FOR CLIENT REVIEW	AA	CEI	CEI	JBF
A	2015-03-30	ISSUED FOR CLIENT REVIEW	AA	CEI	CEI	JBF

SEAL

JEFFREY B. FASSETT  
85675  
LICENSED PROFESSIONAL ENGINEER  
STATE OF TEXAS

GOLDER ASSOCIATES INC.  
TEXAS REGISTRATION F-2578

CLIENT

CONSULTANT

HOUSTON OFFICE  
500 CENTURY PLAZA DR  
HOUSTON, TEXAS 77073  
USA  
(281) 821-6868  
www.golder.com


PROJECT  
OAK GROVE STEAM ELECTRIC STATION  
FGD-C POND  
ROBERTSON COUNTY, TEXAS

TITLE  
**SITE OVERVIEW**

PROJECT No. 1406296 LUMINANT DRAWING NO. A2YF00-0-CV-0-SW.PL-02 Rev. 0 of 7 FIGURE 2

Path: \\uswest\eng\drafting\_2014\1406296\_Luminant\_FGD-C\PRODUCTION\FGD-C\_POND\_1.dwg; File Name: 140629602.dwg

1 in. IF THIS MEASUREMENT DOES NOT MATCH WHAT IS SHOWN, THE SHEET SIZE HAS BEEN MODIFIED FROM ANSI B

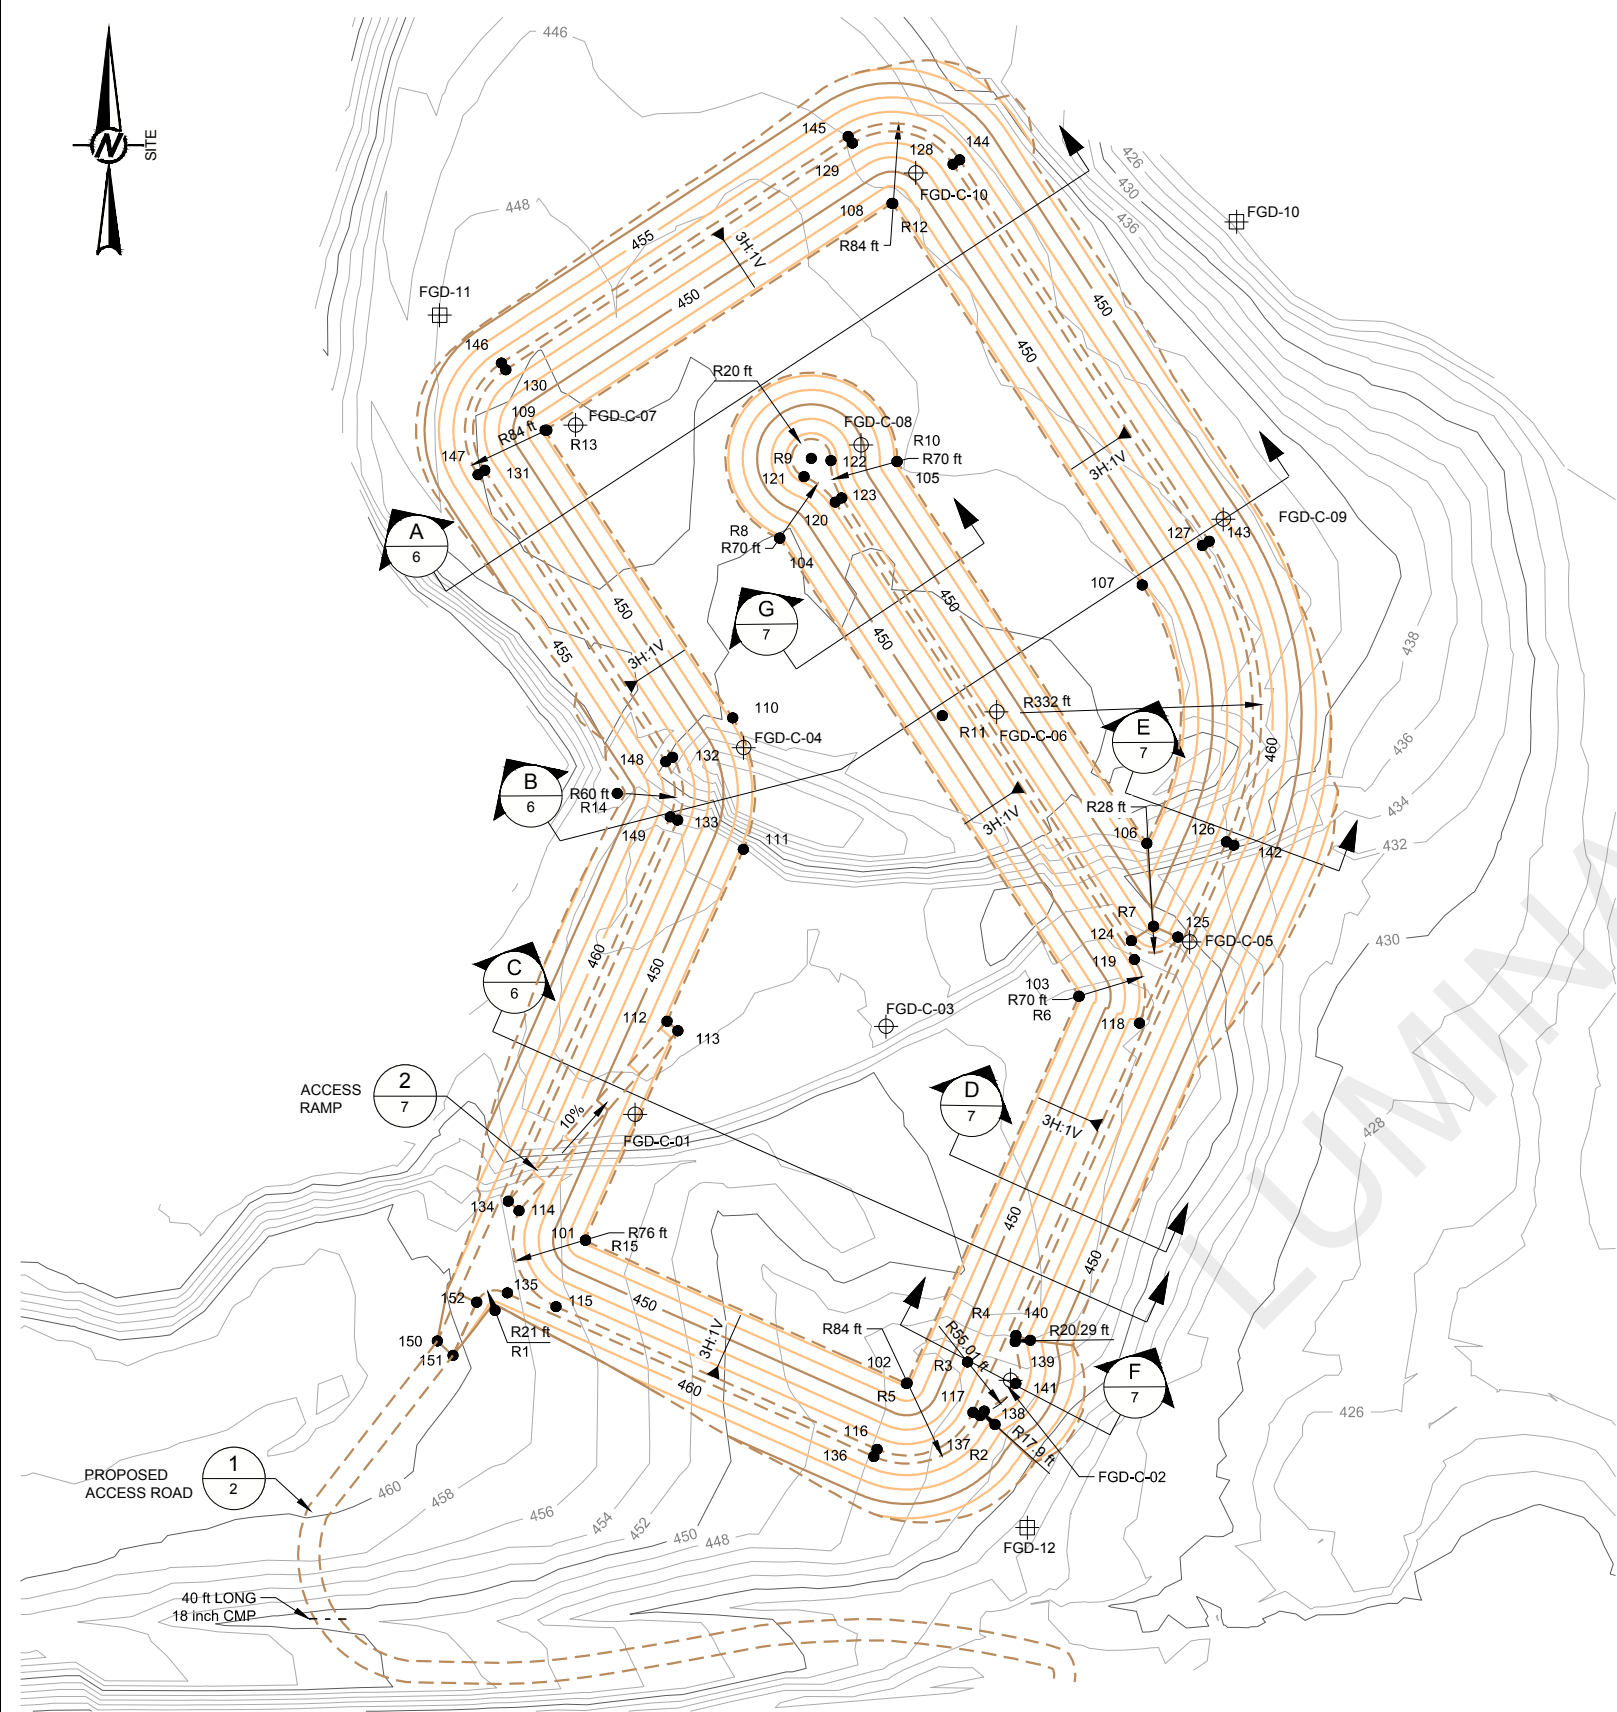

**CONTROL POINT TABLES**

POINT	NORTHING	EASTING	ELEV.
101	4377.31	1408.84	439.00
102	4228.15	1743.04	439.00
103	4631.40	1922.87	439.00
104	5108.52	1611.15	439.00
105	5188.44	1733.34	439.00
106	4790.57	1993.58	439.00
107	5059.86	1988.71	439.00
108	5457.08	1728.90	439.00
109	5221.15	1367.01	439.00
110	4921.44	1562.27	439.00
111	4784.47	1573.33	439.00
112	4605.44	1493.81	439.00
113	4595.52	1505.06	439.00
114	4408.02	1339.70	464.00
115	4308.17	1378.13	464.00
116	4159.60	1712.59	464.00
117	4198.03	1812.44	464.00
118	4603.38	1985.93	464.00
119	4669.78	1980.57	462.00
120	5146.12	1669.01	462.00
121	5172.70	1636.51	462.00
122	5189.50	1664.50	461.95
123	5150.50	1675.70	462.00
124	4689.24	1977.40	462.00
125	4693.15	2025.81	464.00
126	4792.28	2076.40	464.00

POINT	NORTHING	EASTING	ELEV.
127	5100.91	2051.47	464.00
128	5498.13	1791.66	464.00
129	5520.03	1686.95	464.00
130	5283.92	1325.96	464.00
131	5179.20	1304.05	464.00
132	4880.38	1499.50	464.00
133	4814.91	1504.79	464.00
134	4417.94	1328.45	464.00
135	4322.50	1327.50	464.00
136	4151.97	1709.20	464.00
137	4194.64	1820.07	464.00
138	4199.36	1824.24	464.00
139	4271.81	1856.42	464.00
140	4278.07	1857.13	464.00
141	4228.19	1856.99	464.00
142	4788.89	2084.04	464.00
143	5105.48	2058.46	464.00
144	5502.70	1798.65	464.00
145	5527.02	1682.37	464.00
146	5290.91	1321.38	464.00
147	5174.63	1297.07	464.00
148	4875.81	1492.51	464.00
149	4818.30	1497.16	464.00
150	4272.38	1254.66	460.79
151	4257.32	1270.95	460.36
152	4312.76	1295.57	464.00

POINT	NORTHING	EASTING
R1	4304.21	1314.75
R2	4185.34	1835.37
R3	4250.52	1806.71
R4	4273.17	1872.07
R5	4228.48	1743.90
R6	4631.40	1922.87
R7	4704.38	2000.54
R8	5108.52	1611.15
R9	5191.60	1644.04
R10	5188.41	1733.36
R11	4923.70	1780.54
R12	5457.34	1728.16
R13	5220.99	1368.56
R14	4842.79	1442.03
R15	4377.31	1408.84


**LEGEND**

- SUBGRADE GRADE BREAK LINE
- 5 ft SUBGRADE CONTOUR
- 25 ft SUBGRADE CONTOUR
- 5 ft EXISTING CONTOUR
- 25 ft EXISTING CONTOUR
- 101 SURVEY CONTROL POINT
- ⊕ FGD-C-01 BOREHOLE
- ⊕ FGD-01 MONITORING WELL

**NOTES**

1. EXISTING GROUND TOPOGRAPHY IN THE VICINITY OF THE POND IS TAKEN FROM A GROUND SURVEY PERFORMED BY SAM, INC. ON OCTOBER 23, 2014 AND FEBRUARY 4, 2015.
2. PROPOSED CONTOURS SHOWN ARE TOP OF SUBGRADE AND CONTAINMENT DIKE.
3. EXCAVATED SOILS TO BE SEGREGATED AND STOCKPILED AT A LOCATION DESIGNATED BY OWNER.
4. COMPACTED FILL SHALL BE PLACED ON STABLE SUBGRADE FREE OF LOOSE OR ORGANIC MATERIAL. COMPACTED FILL SHALL BE PLACED AND TESTED IN ACCORDANCE WITH THE PROJECT SPECIFICATIONS. UNSTABLE SOILS SHALL BE OVEREXCAVATED AND REPLACED WITH COMPACTED FILL AS DEEMED APPROPRIATE BY THE OWNER OR ENGINEER.
5. CONTROL POINTS SHOWN ARE ON THE LOCAL COORDINATE PLANT GRID SYSTEM.

**ISSUED FOR CONSTRUCTION**

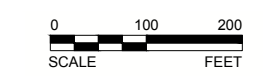

Path: \\luminant\drawing\2014\1406296\_Luminant\_FGD-C\PRODUCTION\FGD-C\_POND\_1.dwg; File Name: 140629603.dwg

Rev.	YYYY-MM-DD	DESCRIPTION	PREPARED	DESIGN	REVIEW	APPROVED
0	2015-04-29	ISSUED FOR CONSTRUCTION	AA	CEI	CEI	JBF
B	2015-04-23	ISSUED FOR CLIENT REVIEW	AA	CEI	CEI	JBF
A	2015-03-30	ISSUED FOR CLIENT REVIEW	AA	CEI	CEI	JBF

SEAL

JEFFREY B. FASSETT  
85675  
LICENSED PROFESSIONAL ENGINEER  
STATE OF TEXAS

GOLDER ASSOCIATES INC.  
TEXAS REGISTRATION F-2578

CLIENT

CONSULTANT

HOUSTON OFFICE  
500 CENTURY PLAZA DR  
HOUSTON, TEXAS 77073  
USA  
(281) 821-6868  
www.golder.com


PROJECT  
OAK GROVE STEAM ELECTRIC STATION  
FGD-C POND  
ROBERTSON COUNTY, TEXAS

TITLE  
**SUBGRADE GRADING PLAN AND CONTAINMENT DIKE**

PROJECT No. 1406296 LUMINANT DRAWING NO. A2YF00-0-CV-0-SW.PL-03 0 Rev. 3 of 7 FIGURE 3

1 in. IF THIS MEASUREMENT DOES NOT MATCH WHAT IS SHOWN, THE SHEET SIZE HAS BEEN MODIFIED FROM ANSI B



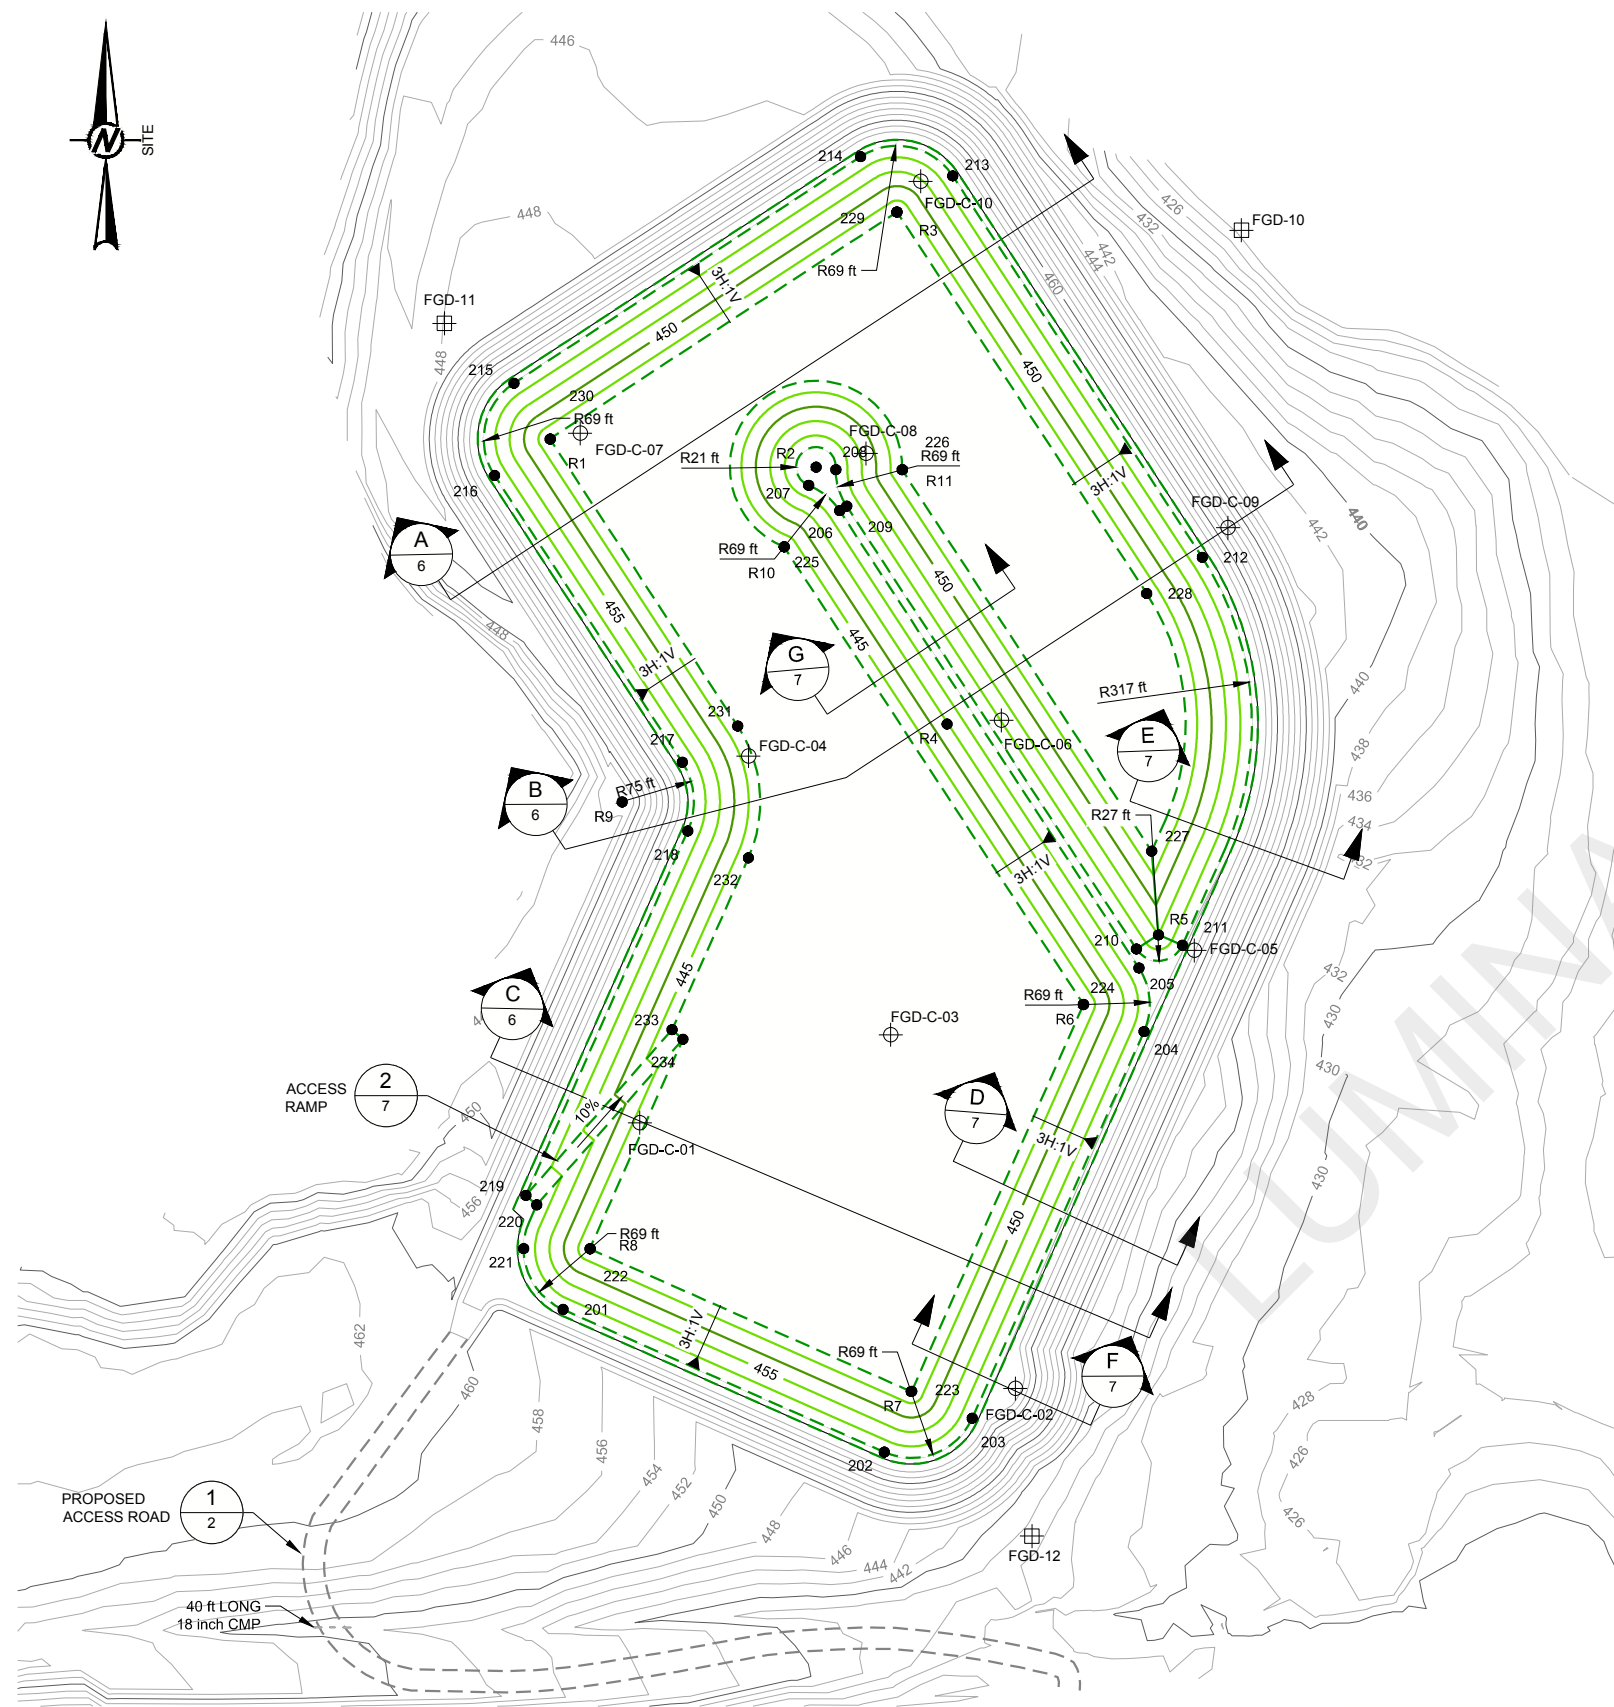

**CONTROL POINT TABLES**

POINT	NORTHING	EASTING	ELEV.
201	4313.95	1380.70	464.00
202	4165.38	1715.16	464.00
203	4200.60	1806.66	464.00
204	4603.52	1985.64	464.00
205	4669.61	1980.30	464.00
206	5145.94	1668.74	464.00
207	5172.40	1636.39	464.00
208	5188.63	1664.67	464.00
209	5150.68	1675.98	464.00
210	4689.42	1977.67	464.00
211	4693.28	2025.51	464.00
212	5097.45	2046.18	464.00
213	5494.67	1786.37	464.00
214	5514.74	1690.41	464.00
215	5278.62	1329.42	464.00
216	5182.66	1309.35	464.00
217	4883.85	1504.79	464.00

POINT	NORTHING	EASTING	ELEV.
218	4812.35	1510.57	464.00
219	4432.81	1341.98	464.00
220	4422.89	1353.23	464.00
221	4377.31	1339.52	464.00
222	4377.01	1408.71	441.00
223	4228.61	1743.60	441.00
224	4631.84	1922.55	441.00
225	5108.26	1610.94	441.00
226	5188.53	1733.66	441.00
227	4791.24	1993.52	441.00
228	5059.68	1988.44	441.00
229	5456.99	1728.18	441.00
230	5220.43	1367.09	441.00
231	4921.62	1562.54	441.00
232	4784.33	1573.63	441.00
233	4605.31	1494.11	441.00
234	4595.39	1505.36	441.00

POINT	NORTHING	EASTING
R1	5220.61	1367.36
R2	5191.33	1644.22
R3	5457.05	1728.35
R4	4923.70	1780.54
R5	4704.11	2000.72
R6	4631.39	1922.46
R7	4228.44	1743.17
R8	4377.31	1408.84
R9	4842.52	1442.21
R10	5108.26	1610.94
R11	5188.63	1733.99

**LEGEND**

- CLAY LINER GRADE BREAK LINE
- 5 ft CLAY LINER CONTOUR
- 25 ft CLAY LINER CONTOUR
- FGD-C-01 BOREHOLE
- FGD-01 MONITORING WELL
- 5 ft EXISTING CONTOUR
- 25 ft EXISTING CONTOUR
- 201 SURVEY CONTROL POINT

**NOTES**

1. EXISTING GROUND TOPOGRAPHY IN THE VICINITY OF THE POND TAKEN FROM A GROUND SURVEY PERFORMED BY SAM, INC. ON OCTOBER 23, 2014 AND FEBRUARY 4, 2015.
2. PROPOSED CONTOURS SHOWN ARE TOP OF CLAY LINER.
3. A MINIMUM OF 2 ft OF COMPACTED CLAY LINER SHALL BE PLACED AND TESTED IN ACCORDANCE WITH THE PROJECT SPECIFICATIONS.
4. CONTROL POINTS SHOWN ARE ON THE LOCAL COORDINATE PLANT GRID SYSTEM.

**ISSUED FOR CONSTRUCTION**



Path: \\luminant\drawing\_201414029296\_Luminant\FGD-C\PRODUCTION\FGD-C.PLD. I File Name: 1402929604.dwg

Rev.	YYYY-MM-DD	DESCRIPTION	PREPARED	DESIGN	REVIEW	APPROVED
0	2015-04-29	ISSUED FOR CONSTRUCTION	AA	CEI	CEI	JBF
B	2015-04-23	ISSUED FOR CLIENT REVIEW	AA	CEI	CEI	JBF
A	2015-03-30	ISSUED FOR CLIENT REVIEW	AA	CEI	CEI	JBF



CLIENT



CONSULTANT




HOUSTON OFFICE  
500 CENTURY PLAZA DR  
HOUSTON, TEXAS 77073  
USA  
(281) 821-6868  
www.golder.com

PROJECT  
OAK GROVE STEAM ELECTRIC STATION  
FGD-C POND  
ROBERTSON COUNTY, TEXAS

TITLE  
**CLAY LINER GRADING PLAN**

1 in. IF THIS MEASUREMENT DOES NOT MATCH WHAT IS SHOWN, THE SHEET SIZE HAS BEEN MODIFIED FROM ANSI B

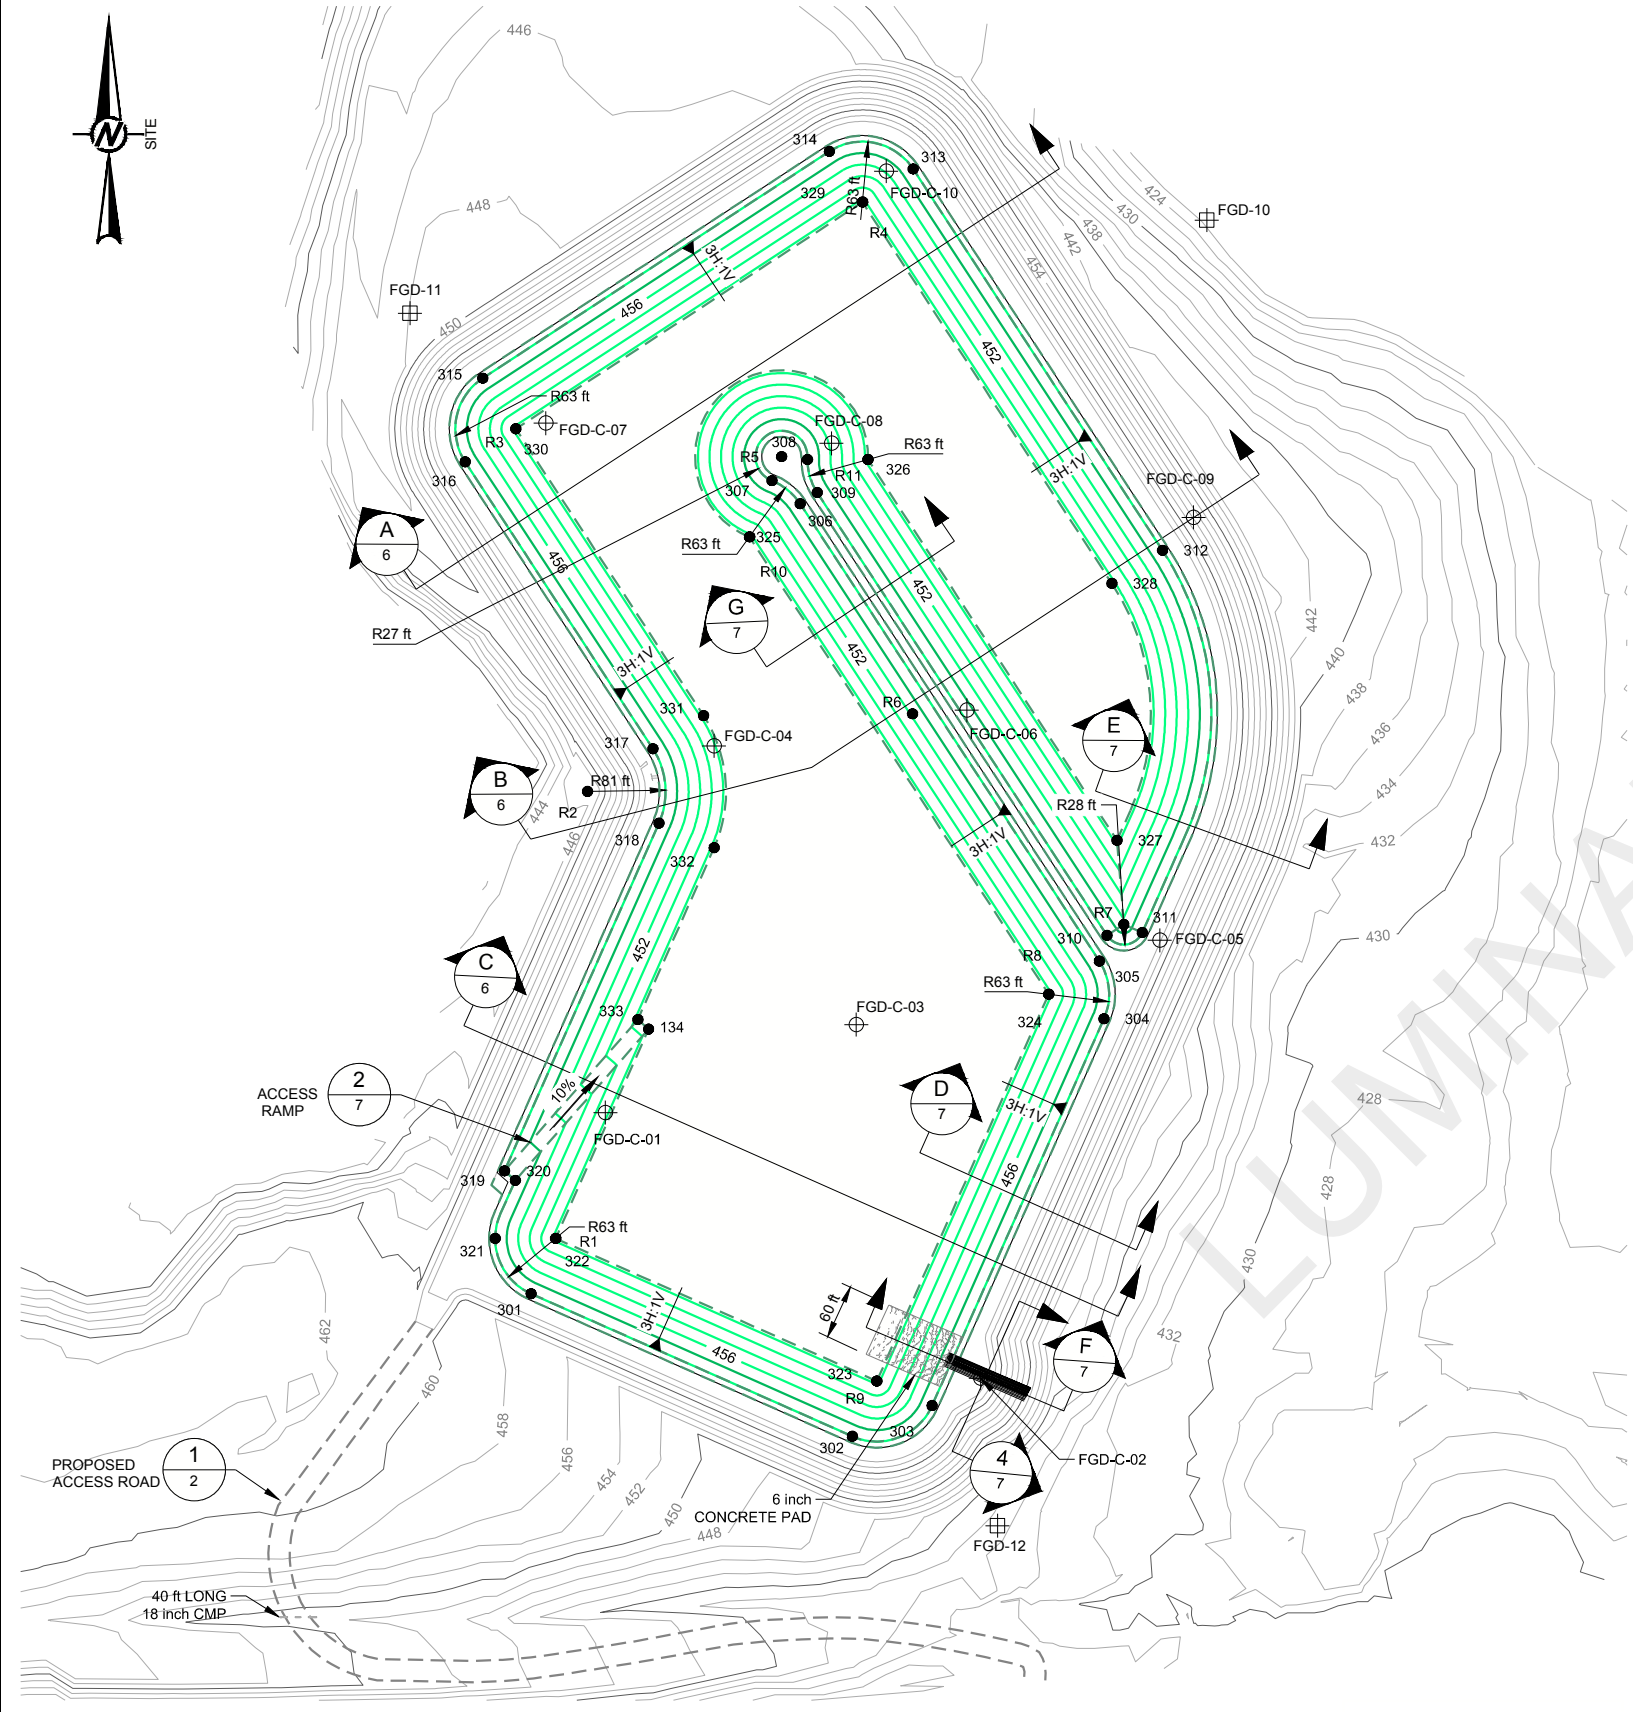

**CONTROL POINT TABLES**

POINT	NORTHING	EASTING	ELEV.
301	4319.73	1383.26	464.00
302	4171.16	1717.73	464.00
303	4203.16	1800.88	464.00
304	4606.08	1979.86	464.00
305	4666.14	1975.00	464.00
306	5142.48	1663.44	464.00
307	5166.52	1634.04	464.00
308	5188.63	1670.99	464.00
309	5154.14	1681.27	464.00
310	4692.88	1982.96	464.00
311	4695.85	2019.73	464.00
312	5093.99	2040.89	464.00
313	5491.21	1781.08	464.00
314	5509.44	1693.87	464.00
315	5273.33	1332.88	464.00
316	5186.12	1314.64	464.00
317	4887.31	1510.09	464.00

POINT	NORTHING	EASTING	ELEV.
318	4809.78	1516.35	464.00
319	4447.68	1355.51	464.00
320	4437.76	1366.76	464.00
321	4377.31	1345.84	464.00
322	4377.31	1408.84	443.00
323	4228.74	1743.30	443.00
324	4631.66	1922.28	443.00
325	5108.00	1610.72	443.00
326	5188.63	1733.99	443.00
327	4791.92	1993.47	443.00
328	5059.50	1988.16	443.00
329	5456.72	1728.35	443.00
330	5220.61	1367.36	443.00
331	4921.79	1562.81	443.00
332	4784.20	1573.93	443.00
333	4605.18	1494.40	443.00


POINT	NORTHING	EASTING
R1	4377.31	1408.84
R2	4842.79	1442.03
R3	5220.61	1367.36
R4	5456.72	1728.35
R5	5191.60	1644.04
R6	4923.70	1780.54
R7	4704.38	2000.54
R8	4631.66	1922.28
R9	4228.74	1743.30
R10	5108.00	1610.72
R11	5188.63	1733.99

**LEGEND**

- PROTECTIVE COVER GRADE BREAK LINE
- 5 ft EXISTING CONTOUR
- 5 ft PROTECTIVE COVER CONTOUR
- 25 ft EXISTING CONTOUR
- 25 ft PROTECTIVE COVER CONTOUR
- 301 SURVEY CONTROL POINT
- ⊕ FGD-C-01 BOREHOLE
- ⊕ FGD-01 MONITORING WELL

- NOTES**
- EXISTING GROUND TOPOGRAPHY IN THE VICINITY OF POND IS TAKEN FROM A GROUND SURVEY PERFORMED BY SAM, INC. ON OCTOBER 23, 2014 FEBRUARY 4, 2015.
  - PROPOSED CONTOURS SHOWN ARE OF PROTECTIVE COVER.
  - A MINIMUM OF 2 ft OF PROTECTIVE COVER SHALL BE PLACED OVER SURVEYOR CERTIFIED TOP OF CLAY LINER IN ACCORDANCE WITH THE PROJECT SPECIFICATIONS.
  - CONTROL POINTS SHOWN ARE ON THE LOCAL COORDINATE PLANT GRID SYSTEM.

**ISSUED FOR CONSTRUCTION**

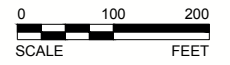

Path: \\server\drawing\2014\1406296\_Luminant FGD-C\PRODUCTION\FGD-C.POND.1 File Name: 1406296.dwg

Rev.	YYYY-MM-DD	DESCRIPTION	PREPARED	DESIGN	REVIEW	APPROVED
0	2015-04-29	ISSUED FOR CONSTRUCTION	AA	CEI	CEI	JBF
B	2015-04-23	ISSUED FOR CLIENT REVIEW	AA	CEI	CEI	JBF
A	2015-03-30	ISSUED FOR CLIENT REVIEW	AA	CEI	CEI	JBF

SEAL

JEFFREY B. FASSETT  
85675  
LICENSED PROFESSIONAL ENGINEER  
STATE OF TEXAS

GOLDER ASSOCIATES INC.  
TEXAS REGISTRATION F-2578

CLIENT

CONSULTANT


HOUSTON OFFICE  
500 CENTURY PLAZA DR  
HOUSTON, TEXAS 77073  
USA  
(281) 821-6868  
www.golder.com

PROJECT  
OAK GROVE STEAM ELECTRIC STATION  
FGD-C POND  
ROBERTSON COUNTY, TEXAS


TITLE  
**PROTECTIVE COVER GRADING PLAN**

PROJECT No. 1406296 LUMINANT DRAWING NO. A2YF00-00CV-0-SW.PL-05 Rev. 5 of 7 FIGURE 5


1 in. IF THIS MEASUREMENT DOES NOT MATCH WHAT IS SHOWN, THE SHEET SIZE HAS BEEN MODIFIED FROM ANSI B

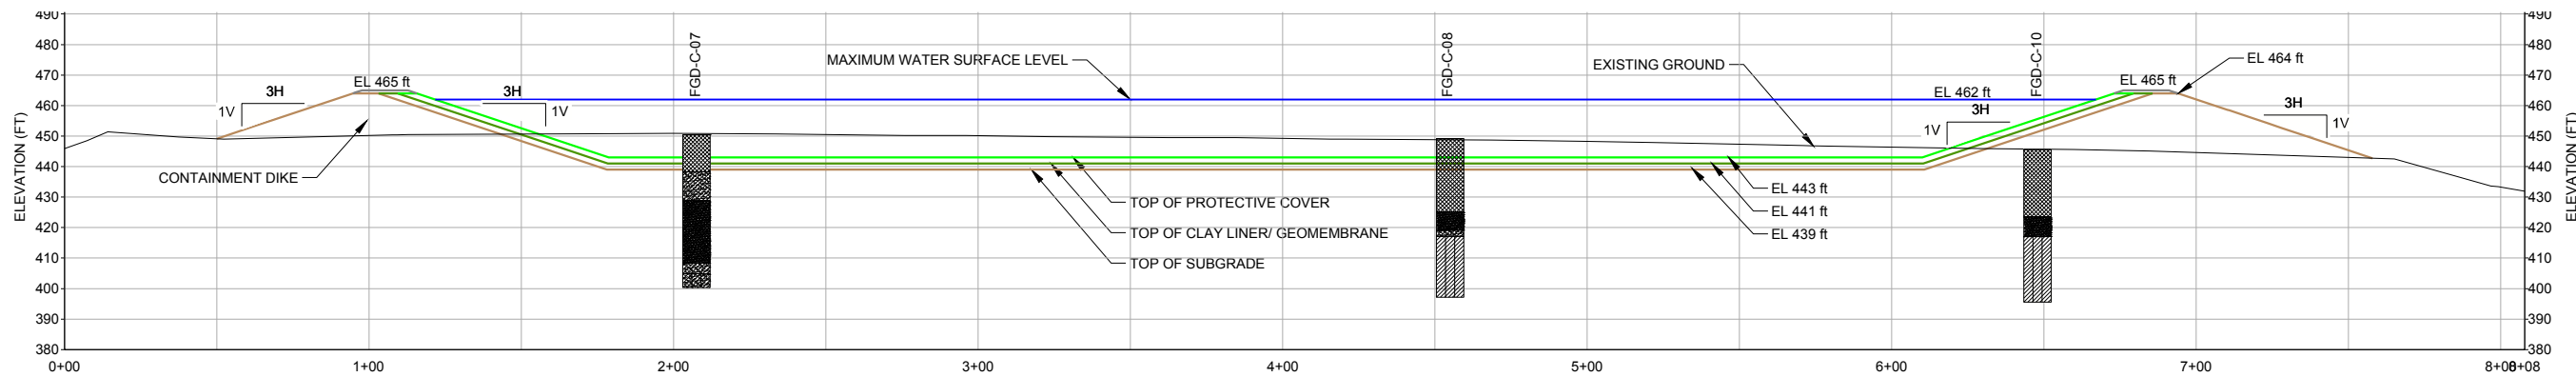

SCALE 1" = 60' **A** PROFILE

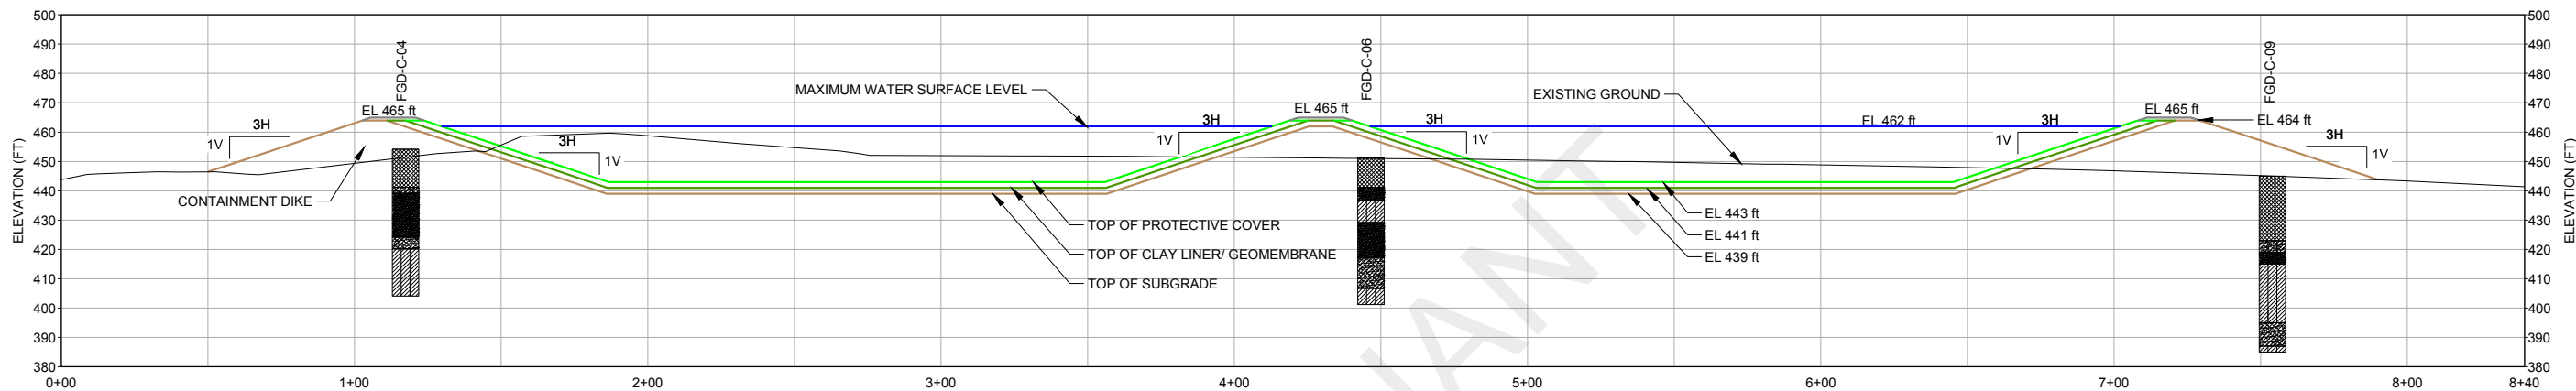

SCALE 1" = 60' **B** PROFILE

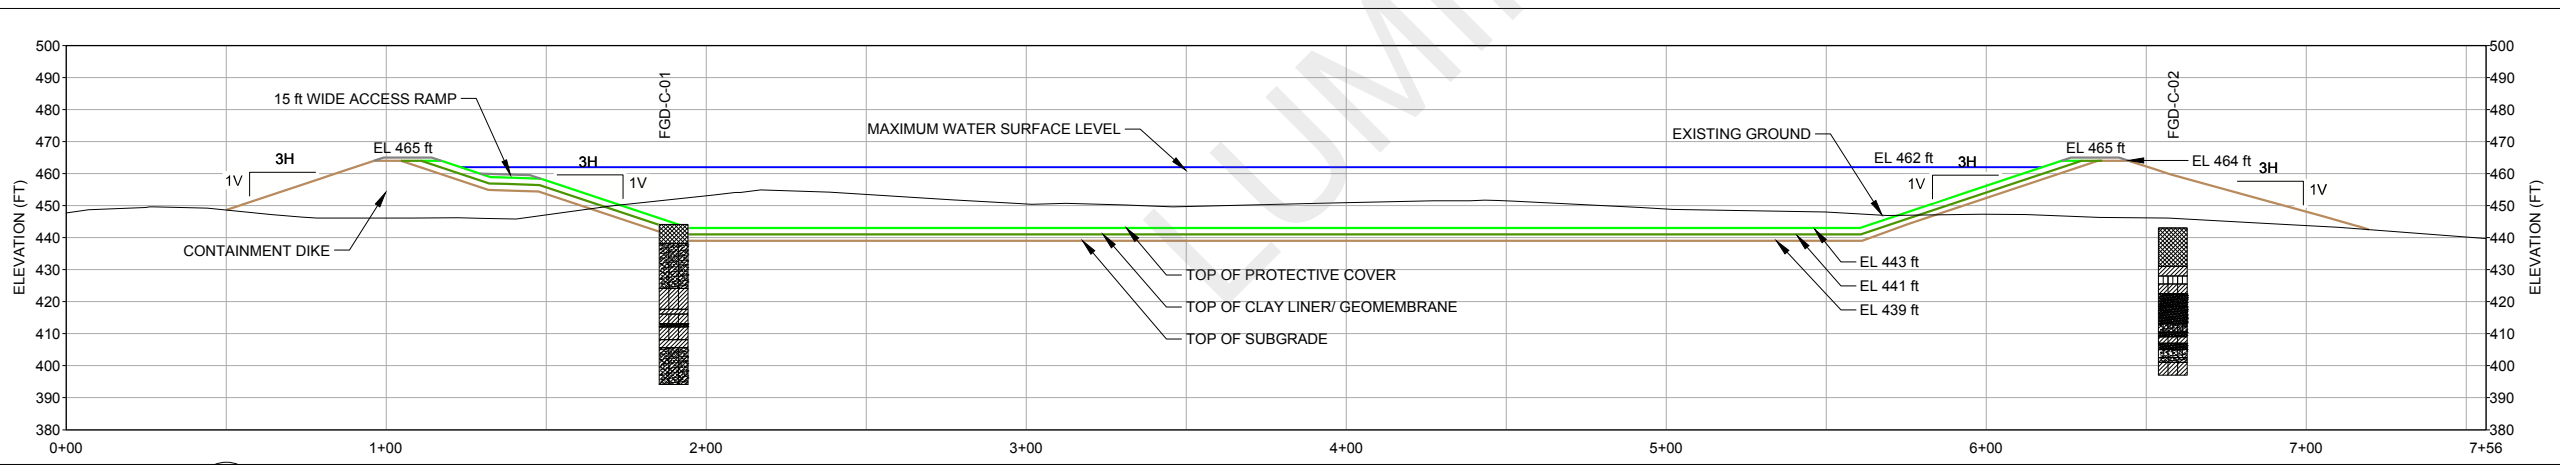


SCALE 1" = 60' **C** PROFILE

**LEGEND**

	POSSIBLE FILL, VERY STIFF		CLAY		SANDY SILT		CLAYEY SILT
	SILT		SILTY SAND		SANDY CLAY		SANDY SILTY CLAY
	SAND		SILTY CLAY		CLAYEY SAND		

**ISSUED FOR CONSTRUCTION**

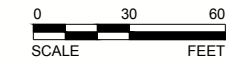

Path: \\server\drawing\_20141406296\_Luminant FGD-C\PRODUCTION\FGD-C\Profile A.dwg

1 in. IF THIS MEASUREMENT DOES NOT MATCH WHAT IS SHOWN, THE SHEET SIZE HAS BEEN MODIFIED FROM ANSI B

Rev.	YYYY-MM-DD	DESCRIPTION	PREPARED	DESIGN	REVIEW	APPROVED
0	2015-04-29	ISSUED FOR CONSTRUCTION	AA	CEI	CEI	JBF
B	2015-04-23	ISSUED FOR CLIENT REVIEW	AA	CEI	CEI	JBF
A	2015-03-30	ISSUED FOR CLIENT REVIEW	AA	CEI	CEI	JBF



CLIENT

**Luminant**

CONSULTANT

**Golder Associates**

HOUSTON OFFICE  
500 CENTURY PLAZA DR  
HOUSTON, TEXAS 77073  
USA  
(281) 821-6868  
www.golder.com


PROJECT  
**OAK GROVE STEAM ELECTRIC STATION  
FGD-C POND  
ROBERTSON COUNTY, TEXAS**

TITLE  
**PROFILES**


PROJECT No. 1406296 LUMINANT DRAWING NO. A2YF00-0-CV-0-SW.PL-06 Rev. 0

Rev. 6 of 7 FIGURE 6




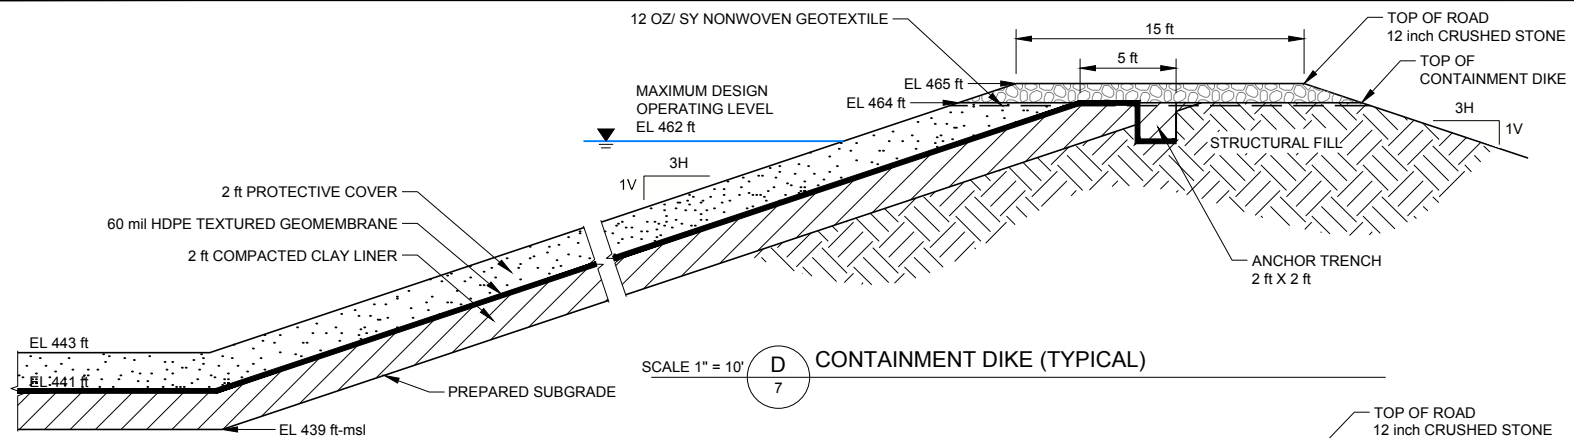


SCALE 1" = 10'  
D CONTAINMENT DIKE (TYPICAL)  
7

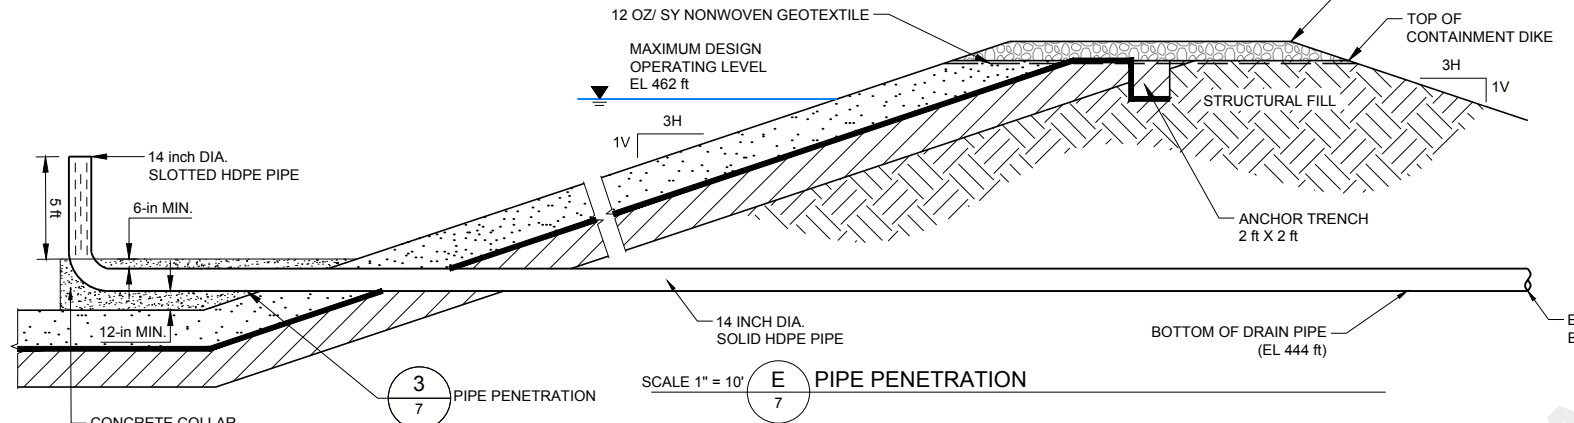


SCALE 1" = 10'  
E PIPE PENETRATION  
7

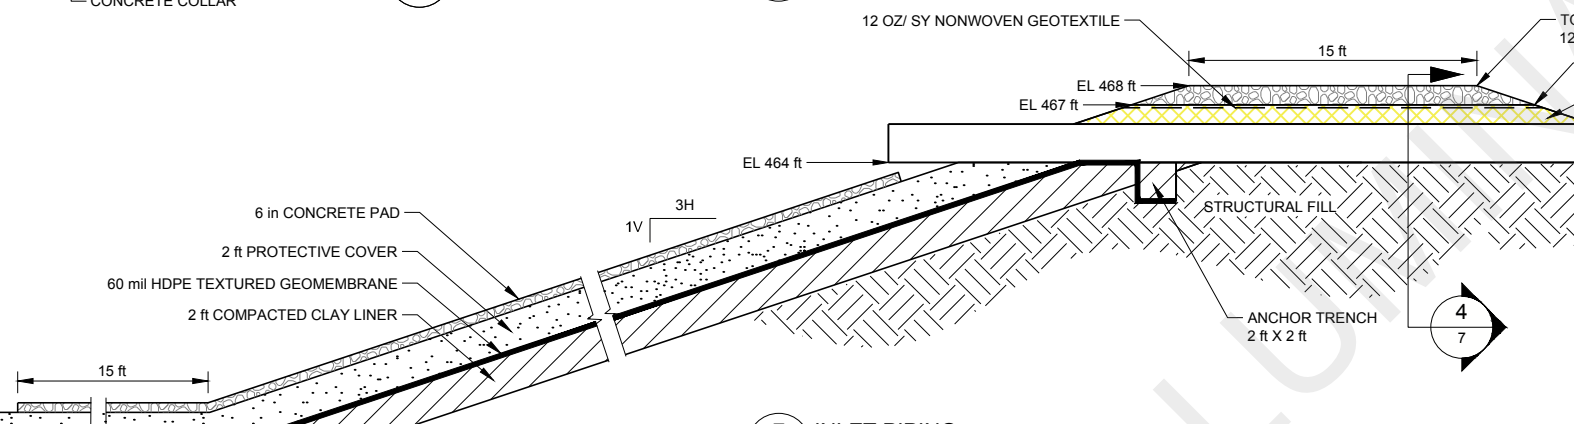


SCALE 1" = 10'  
F INLET PIPING  
7

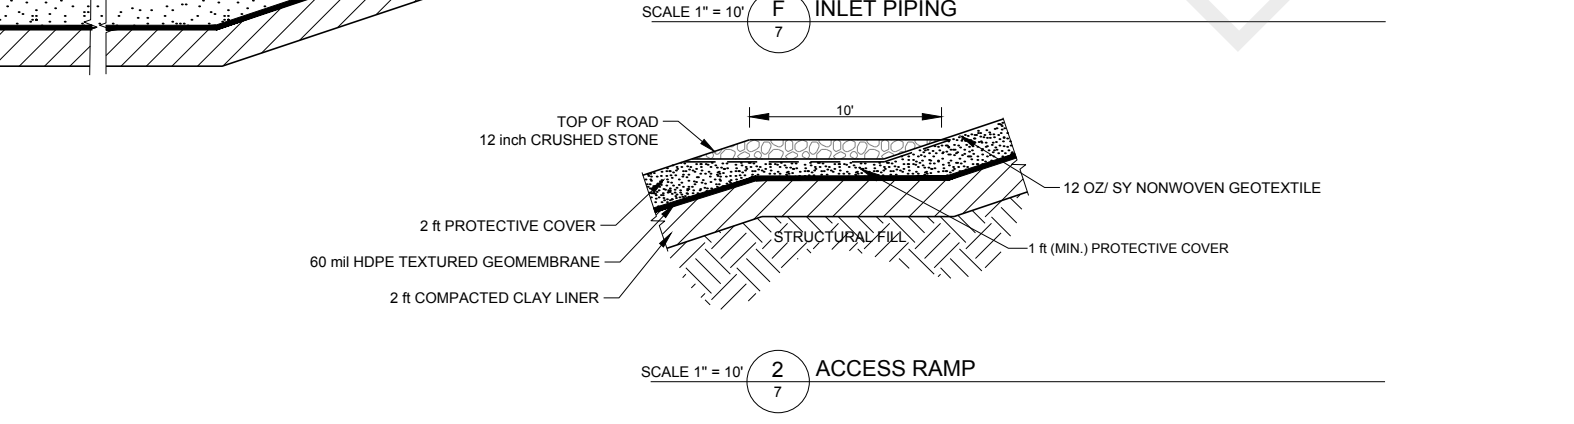


SCALE 1" = 10'  
2 ACCESS RAMP  
7

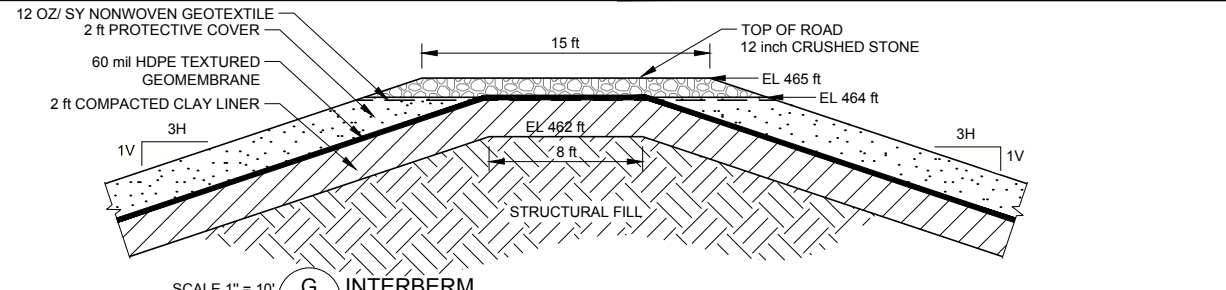

SCALE 1" = 10'  
G INTERBERM  
7

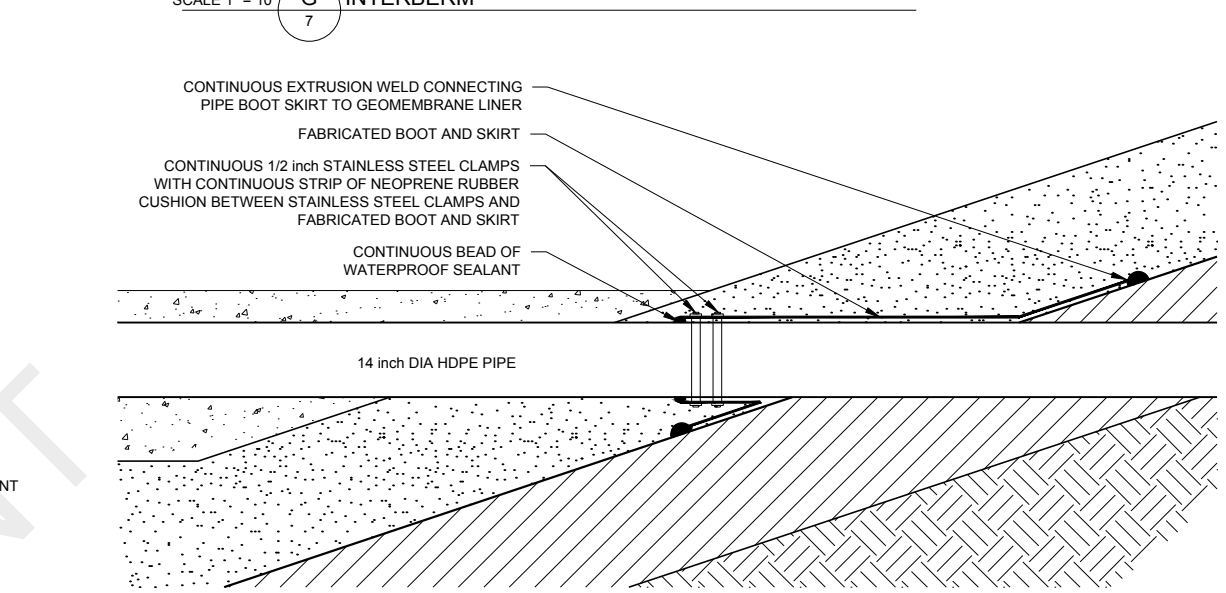


SCALE 1" = 3'  
3 PIPE PENETRATION DETAIL  
7

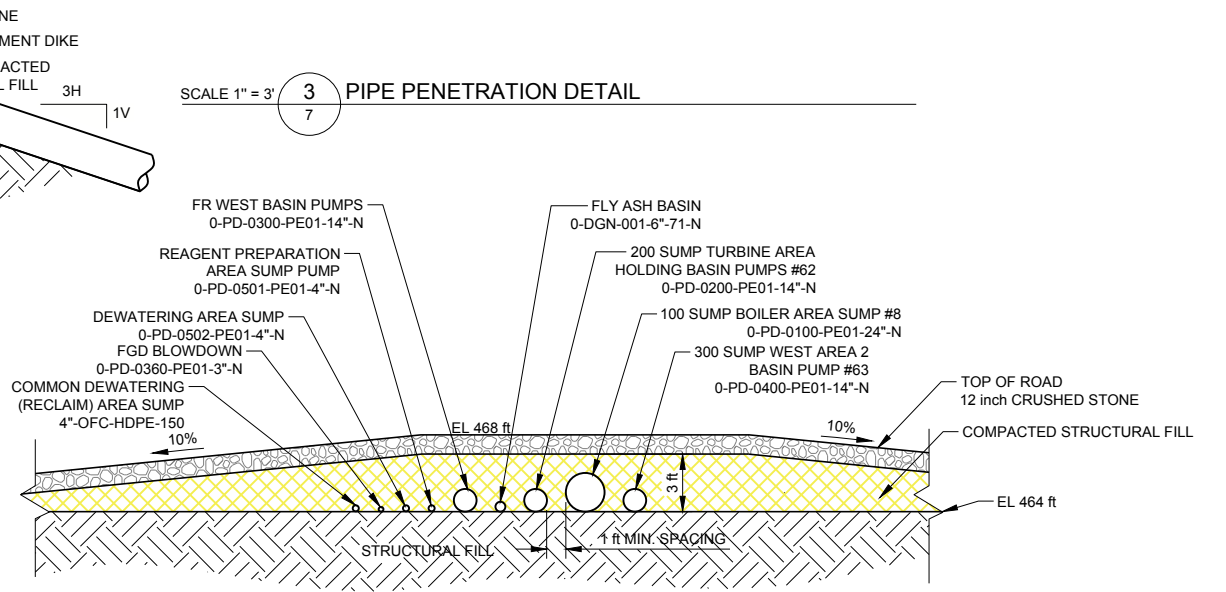

SCALE 1" = 10'  
4 INLET PIPING  
7

ISSUED FOR CONSTRUCTION

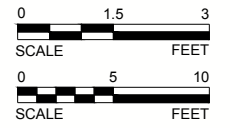

Path: \\luminant\drawing\_20141406296\_Luminant FGD-C\PRODUCTION\B - POND - I File Name: 1406296007.dwg

Rev.	YYYY-MM-DD	DESCRIPTION	PREPARED	DESIGN	REVIEW	APPROVED
0	2015-04-29	ISSUED FOR CONSTRUCTION	AA	CEI	CEI	JBF
B	2015-04-23	ISSUED FOR CLIENT REVIEW	AA	CEI	CEI	JBF
A	2015-03-30	ISSUED FOR CLIENT REVIEW	AA	CEI	CEI	JBF

SEAL

JEFFREY B. FASSETT  
85675  
LICENSED PROFESSIONAL ENGINEER  
STATE OF TEXAS

GOLDER ASSOCIATES INC.  
TEXAS REGISTRATION F-2578

CLIENT

CONSULTANT

HOUSTON OFFICE  
500 CENTURY PLAZA DR  
HOUSTON, TEXAS 77073  
USA  
(281) 821-6868  
www.golder.com

PROJECT  
OAK GROVE STEAM ELECTRIC STATION  
FGD-C POND  
ROBERTSON COUNTY, TEXAS

TITLE  
DETAILS

PROJECT No. 1406296 LUMINANT DRAWING NO. A2YF00-0-CV-0-SW.PL-07 Rev. 7 of 7 FIGURE 7



1 in. IF THIS MEASUREMENT DOES NOT MATCH WHAT IS SHOWN, THE SHEET SIZE HAS BEEN MODIFIED FROM ANSI B





**FDG A  
AS BUILT DRAWINGS**

LUMINANT



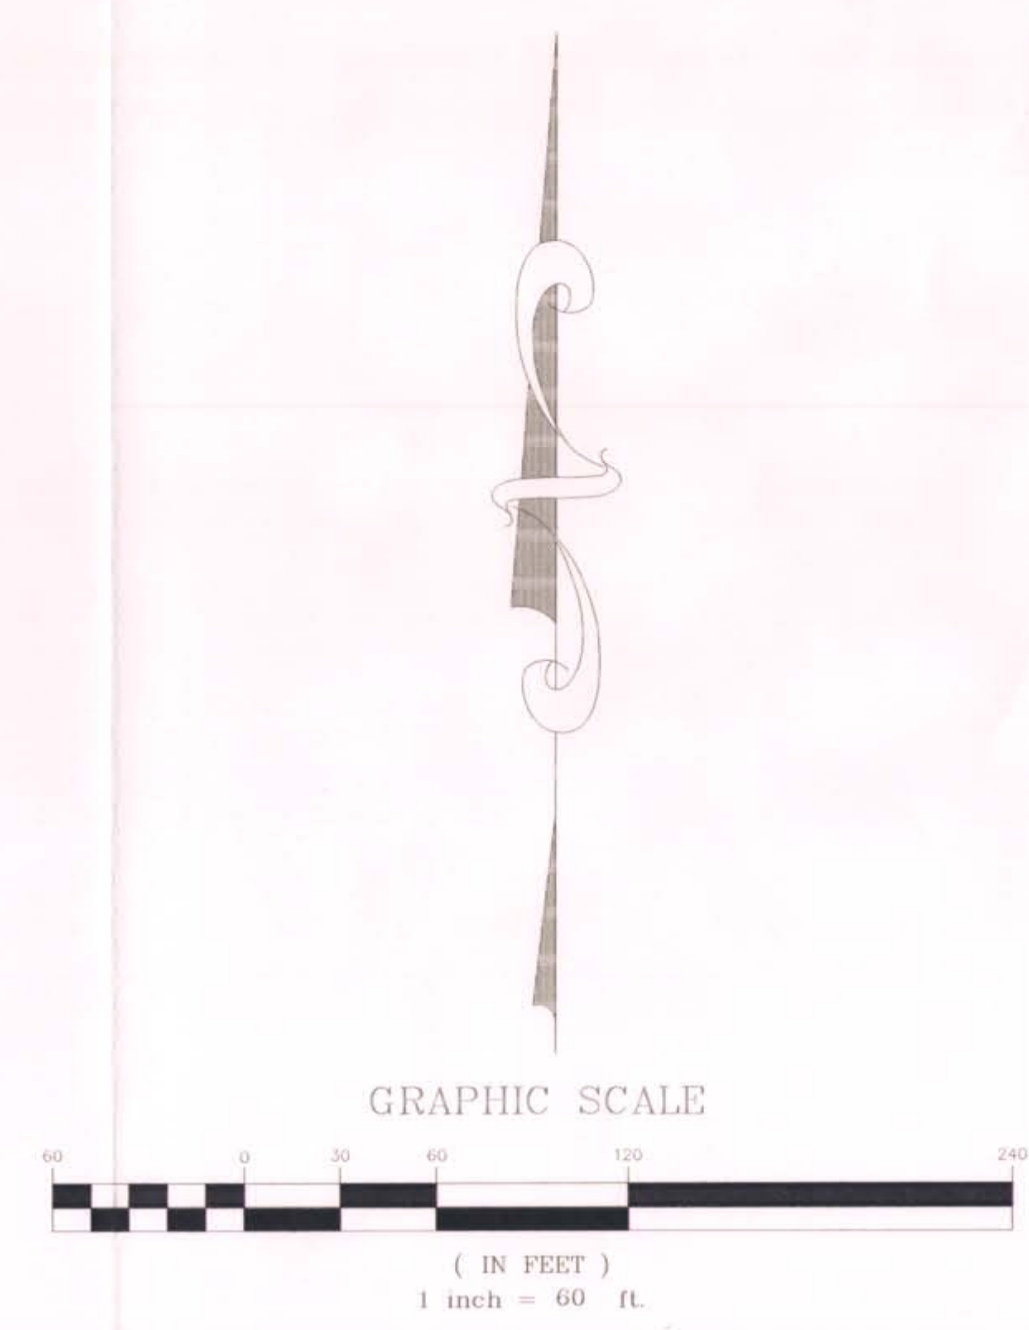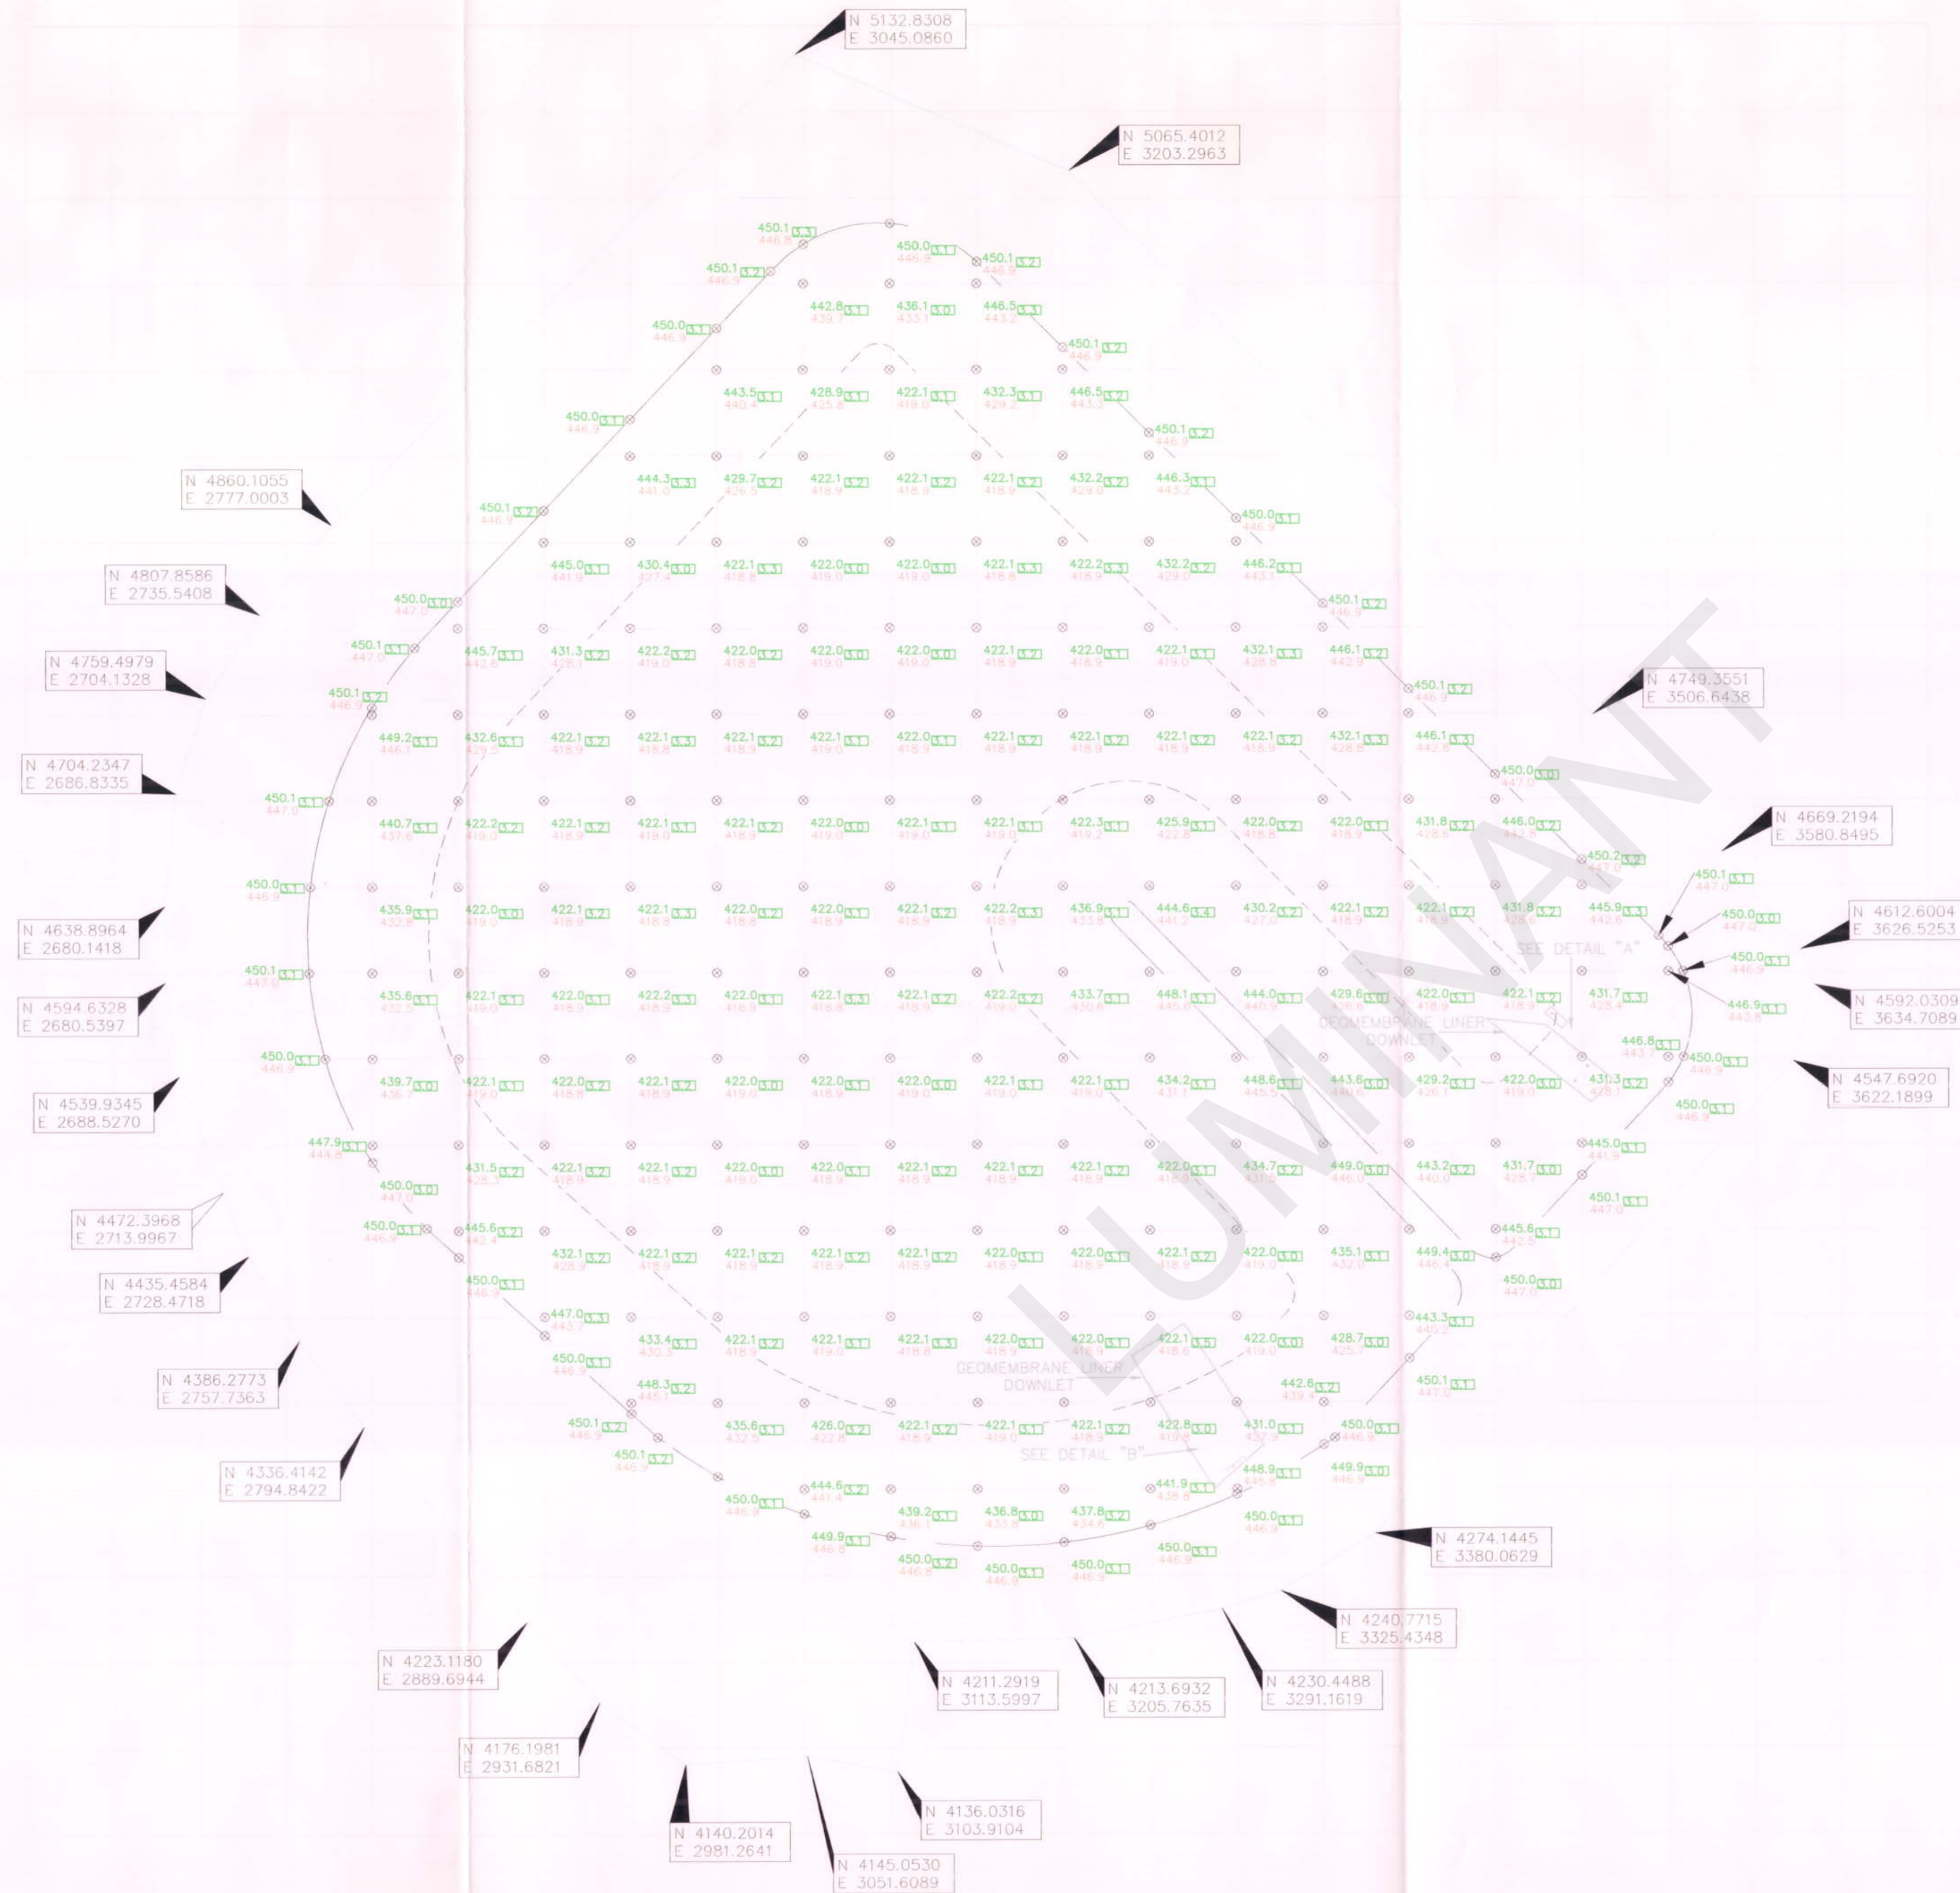


**LEGEND**  
 NORTHING N 10097536.58 F.G.D. POND BOUNDARY  
 EASTING E 3145608.31  
 CERTIFIED CLAY LINER ELEVATION 547.0' CLAY LINER THICKNESS  
 CERTIFIED SUBGRADE ELEVATION 545.0'

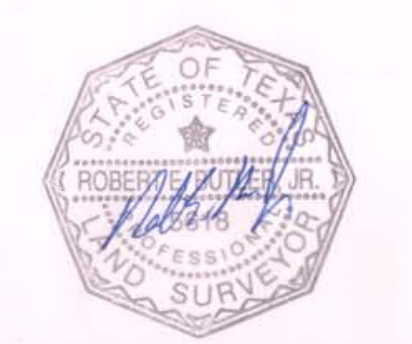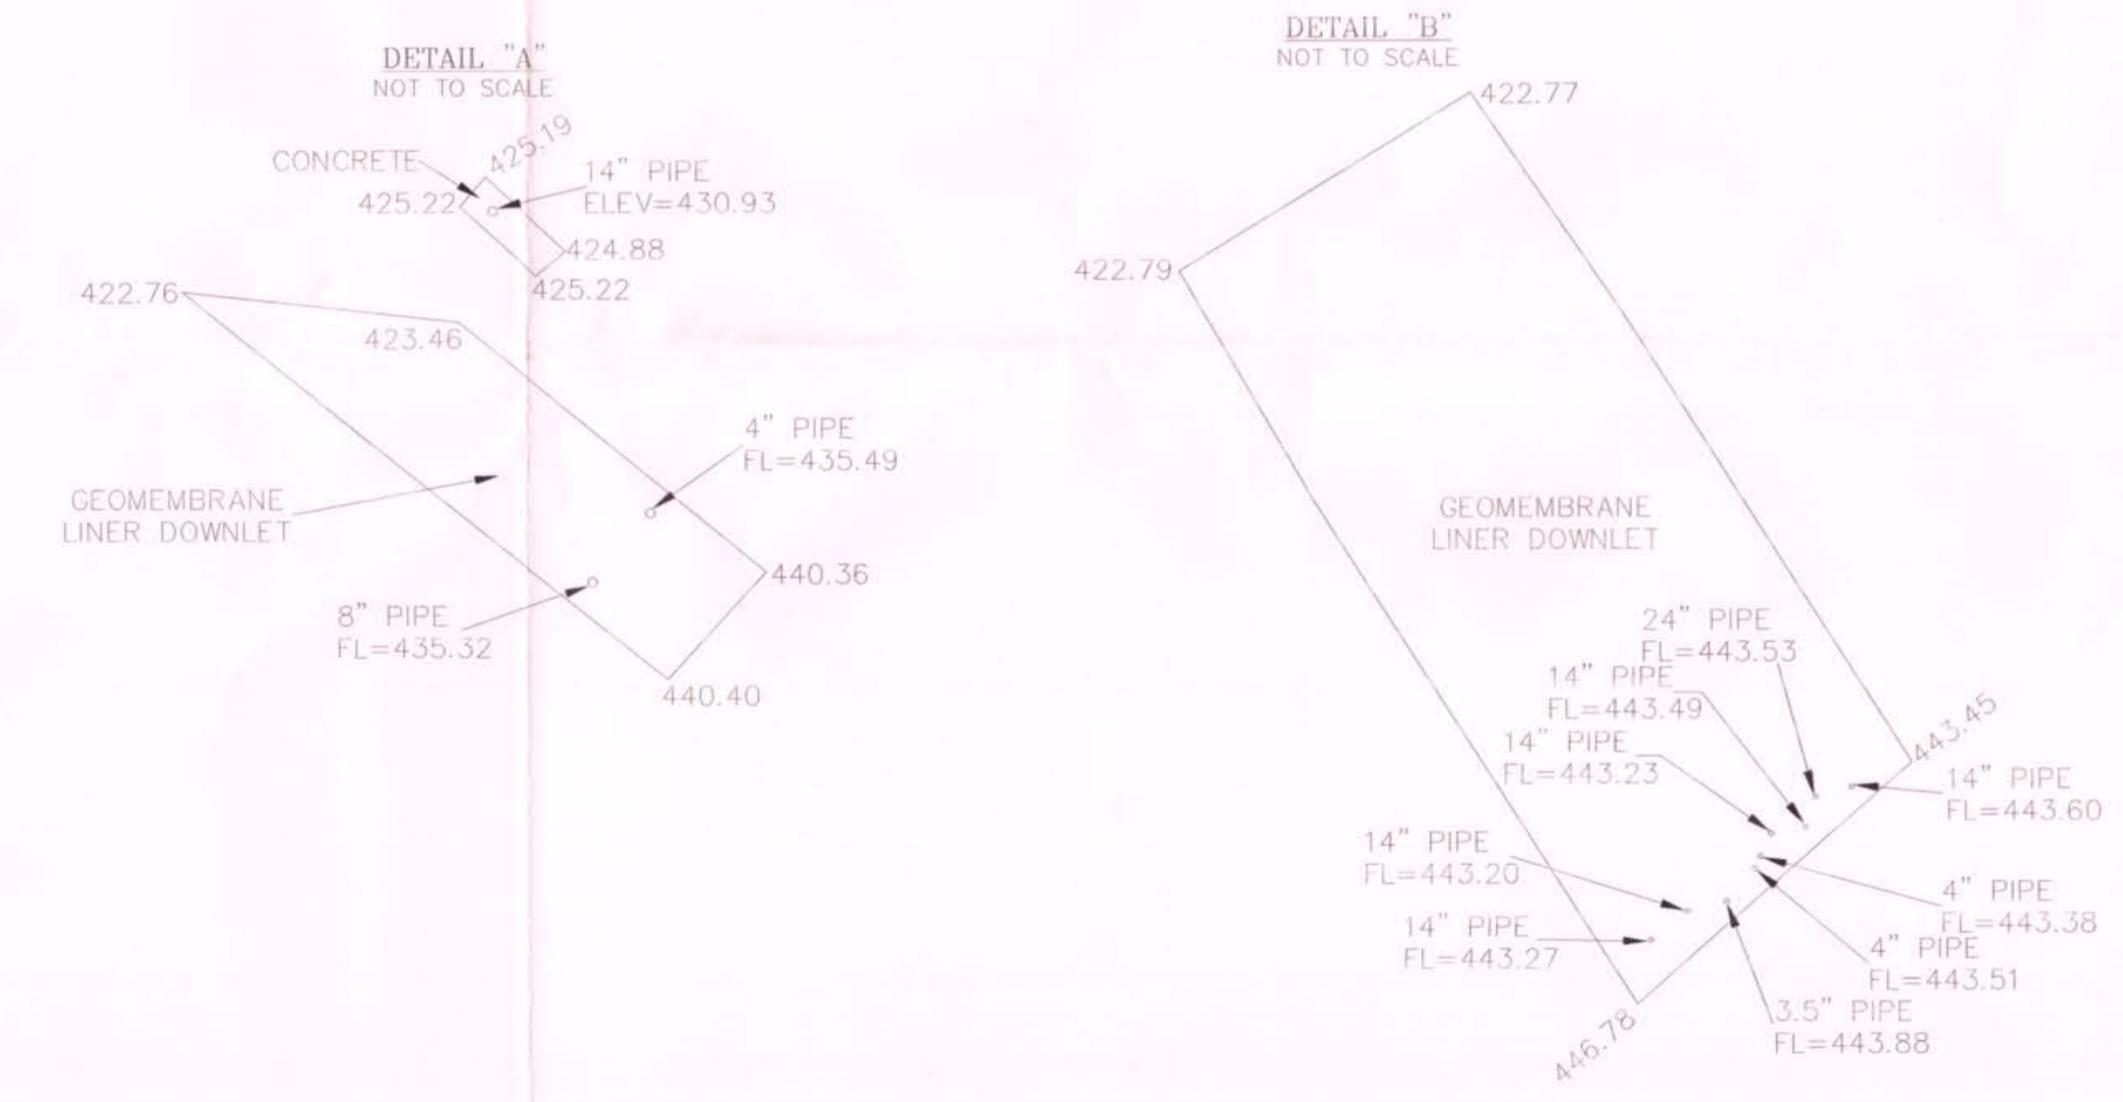

NO.	REVISIONS	BY	DATE

PROJECT: JAMES CONSTRUCTION  
 OAK GROVE FGD POND  
 JOB NUMBER: 28172-09  
 DATE: NOVEMBER 19, 2008  
 SCALE: 1" = 60'  
 SURVEYOR: R.E.B.  
 TECHNICIAN: G.HANSON  
 DRAWING: OAK GROVE POND.DWG  
 FIELDNOTES: N/A  
 PARTYCHIEF: J.SANDOVAL  
 FIELDBOOKS: 6283

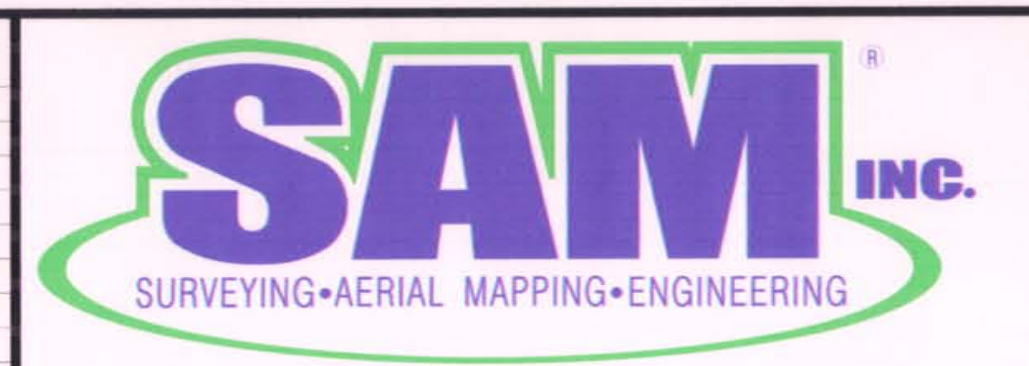

5508 WEST HIGHWAY 290  
 BUILDING B  
 AUSTIN TEXAS, 78735  
 (512) 447-0575  
 FAX: (512) 326-3029  
 EMAIL: SAM@SAMINC.BIZ

SUBGRADE AND CLAY LINER ELEVATIONS  
 AS OF OCTOBER 23, 2008  
 OAK GROVE POWER PLANT - F.G.D. POND  
 ROBERTSON COUNTY, TEXAS

SHEET 1  
 OF 1

DWG. NO.:



**FDG B  
AS BUILT DRAWINGS**

LUMINANT








**FDG C  
AS BUILT DRAWINGS**


LUMINANT

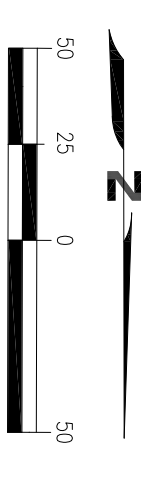

LEGEND

x475 CERTIFICATION POINT

--- BREAKLINE

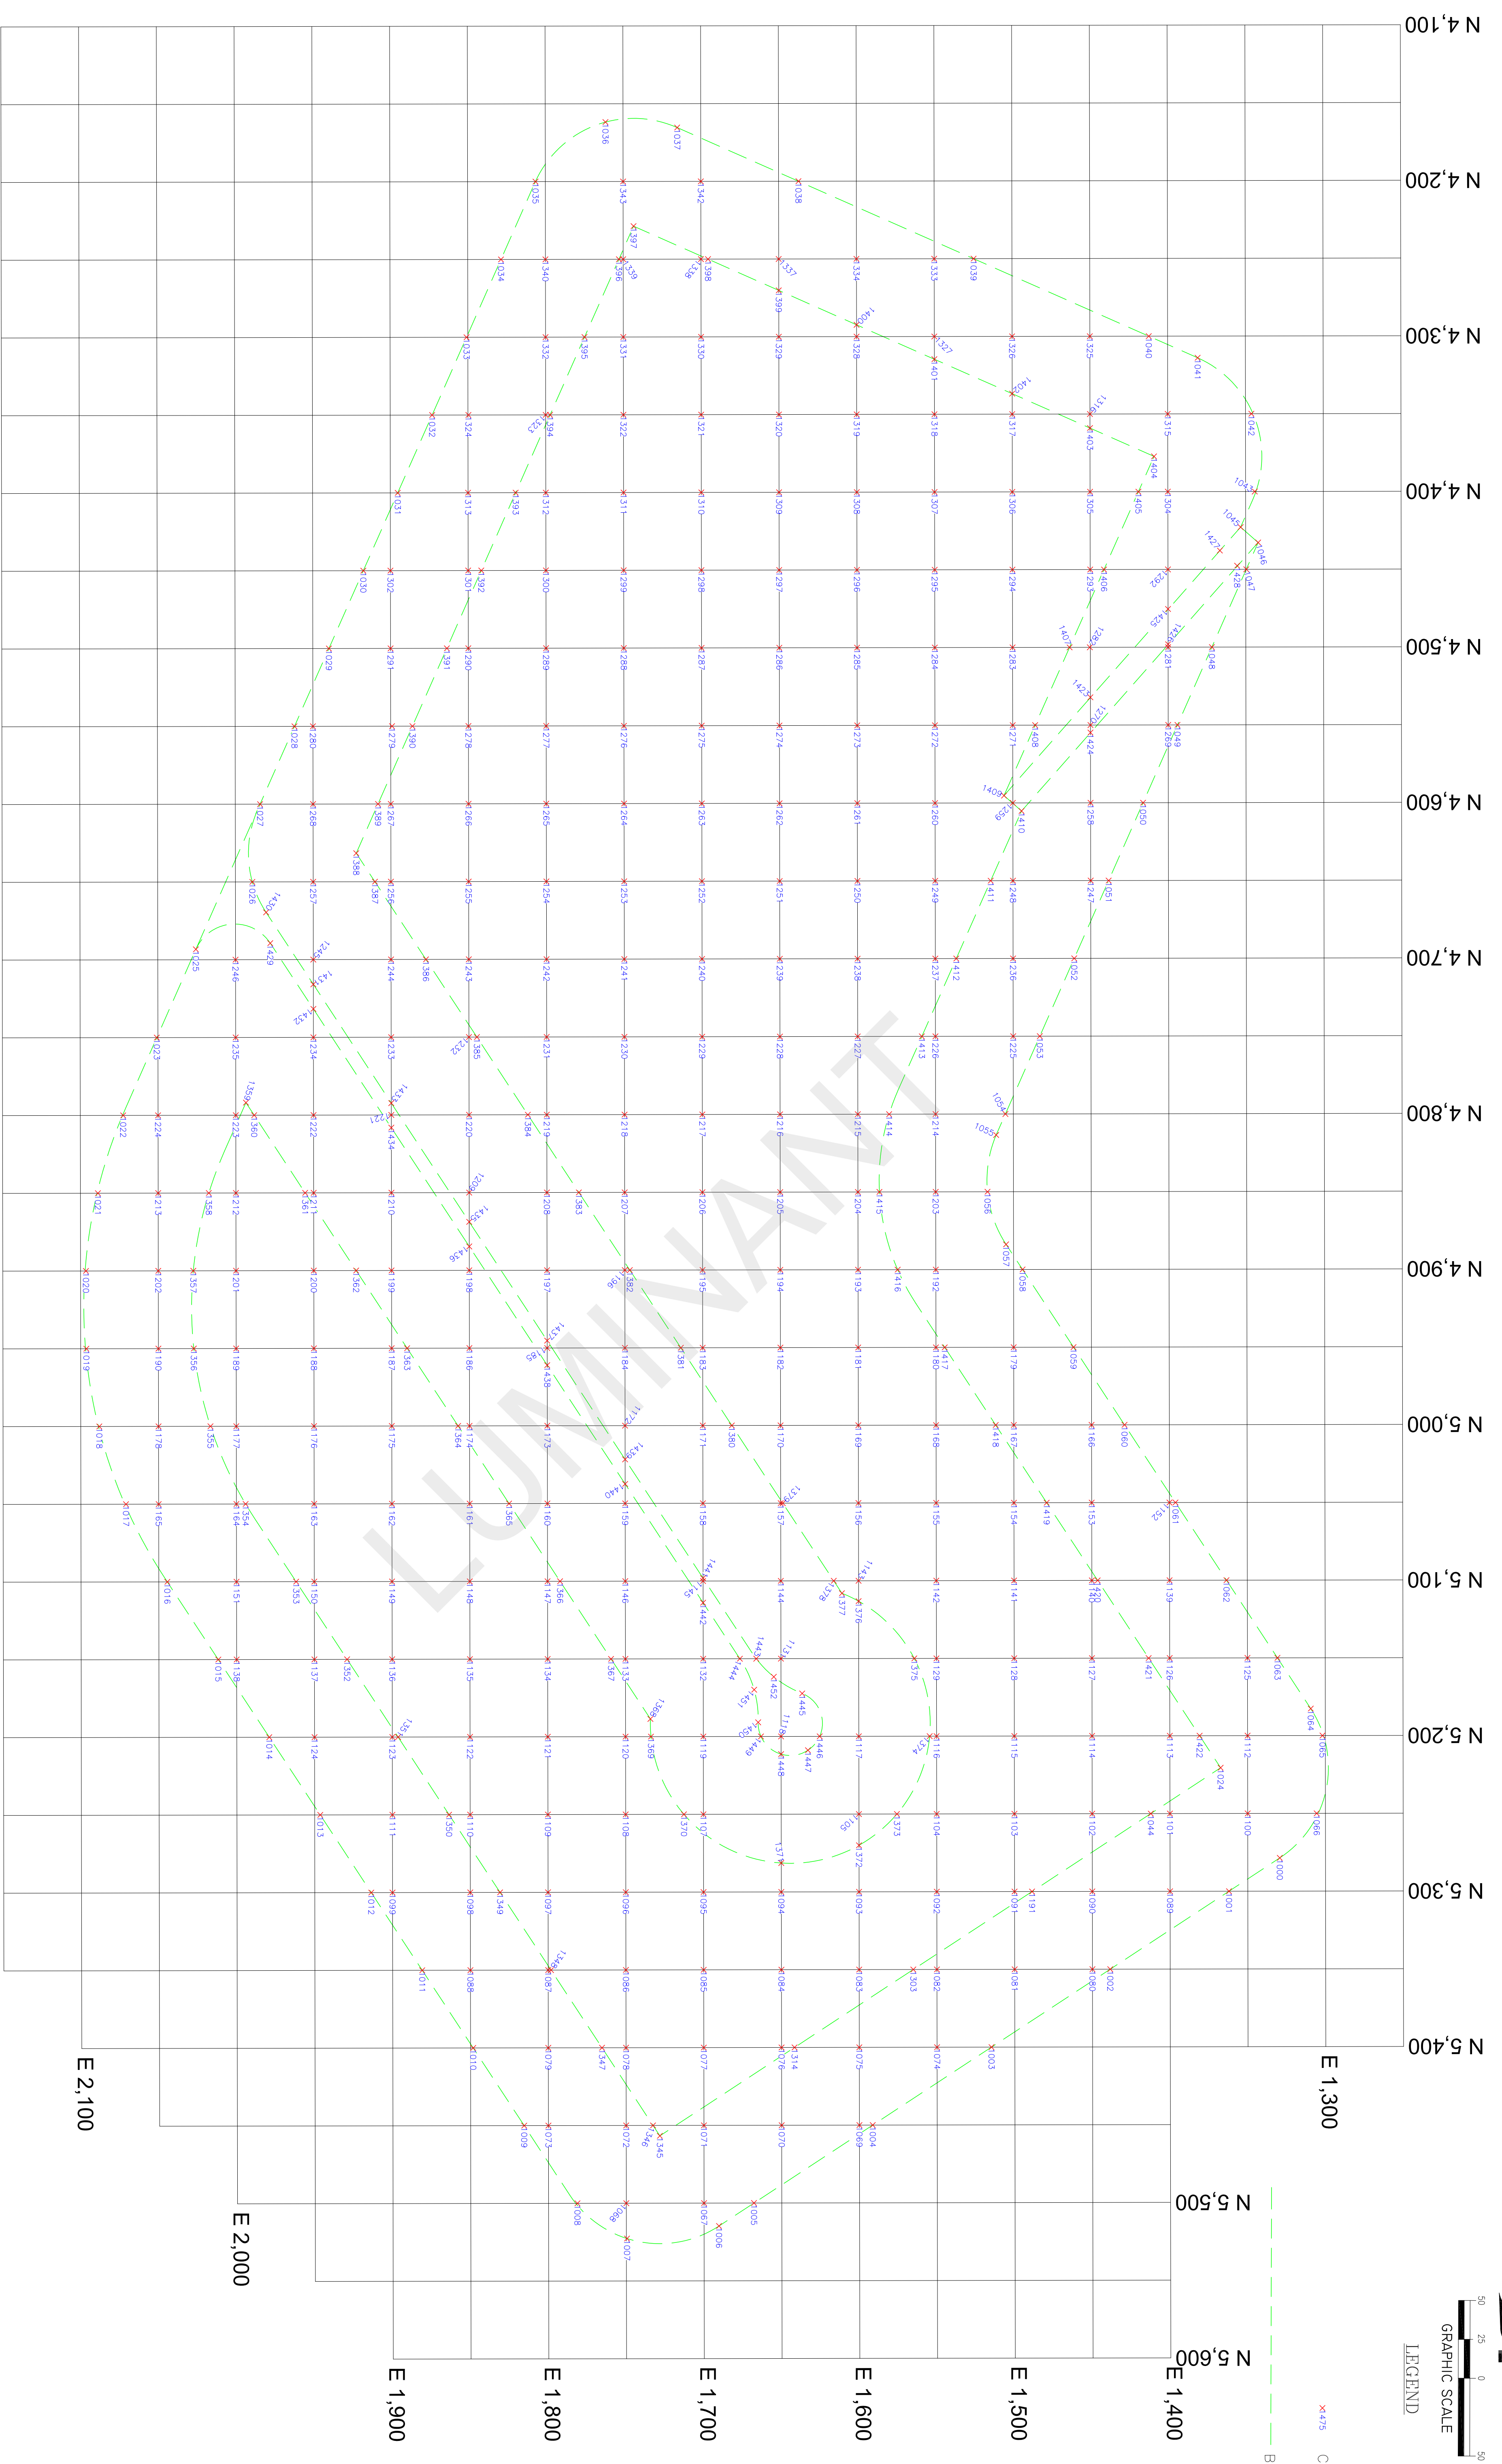

NO.	REVISIONS	BY	DATE

PROJECT: GOLDER ASSOCIATES  
 OAK GROVE FGD POND C  
 JOB NUMBER: 35813-09  
 DATE: AUGUST 18, 2016  
 SCALE: 1"=50'  
 SURVEYOR: SKM  
 TECHNICIAN: WGT  
 FIELD NUMBER: 17213 FGD POND C.DWG  
 SURVEYOR: J. SANDOVAL  
 FIELD BOOKS: 9999

SUBGRADE AND CLAY LINER ELEVATIONS  
 AS OF SEPTEMBER 29, 2015  
 FGD POND C  
 OAK GROVE POWER PLANT  
 ROBERTSON COUNTY, TEXAS

SHEET 1  
 OF 2  
 DWG. NO.: 35813-09



701 ENVY COURT  
 DALLAS, TEXAS 75247  
 (214) 651-7888  
 FAX: (214) 651-7105  
 EMAIL: SAM@SAM.BIZ





**ATTACHMENT 2  
AREA CAPACITY CURVES**

LUMINANT




**Date:** July 5, 2016  
**Project No.:** 1648164  
**Subject:** FGD-A, FGD-B, FGD-C Area Capacity Curves  
**Project Short Title:** Luminant CCR Support

**Made by:** AGM  
**Checked by:** VK  
**Reviewed by:** JBF

	Stage (ft)	Elevation (ft-msl)	Area (ft <sup>2</sup> )	Incremental Volume (acre-ft)	Cumulative Volume (acre-ft)	Area Capacity Curve
FGD-A	1	422	203733	0.0	0	 <p>FGD-A</p> <p>Note: Maximum design operating level is 448 ft.</p>
	2	423	209,836	4.7	5	
	3	424	215,986	4.9	10	
	4	425	222,184	5.0	15	
	5	426	228,431	5.2	20	
	6	427	234,727	5.3	25	
	7	428	241,063	5.5	31	
	8	429	247,456	5.6	36	
	9	430	253,888	5.8	42	
	10	431	260,372	5.9	48	
	11	432	266,886	6.1	54	
	12	433	273,441	6.2	60	
	13	434	280,042	6.4	66	
	14	435	286,685	6.5	73	
	15	436	293,375	6.7	80	
	16	437	300,109	6.8	86	
	17	438	306,888	7.0	93	
	18	439	313,712	7.1	101	
	19	440	320,580	7.3	108	
	20	441	327,492	7.4	115	
	21	442	334,451	7.6	123	
	22	443	341,453	7.8	131	
	23	444	348,499	7.9	139	
	24	445	355,584	8.1	147	
	25	446	362,726	8.2	155	
	26	447	369,907	8.4	163	
	27	448	377,132	8.6	172	
	28	449	384,402	8.7	181	
	29	450	391,789	8.9	190	
FGD-B	1	416	39958	0	0	 <p>FGD-B</p> <p>Note: Maximum design operating level is 429.5 ft.</p>
	2	417	98233	2	2	
	3	418	158638	3	5	
	4	419	220911	4	9	
	5	420	285836	6	15	
	6	421	347894	7	22	
	7	422	383271	8	30	
	8	423	403466	9	39	
	9	424	411926	9	49	
	10	425	420443	10	58	
	11	426	429015	10	68	
	12	427	437649	10	78	
	13	428	446337	10	88	
	14	429	455083	10	99	
	14.5	429.5	459629	5	104	
	15	430	463,885	5.3	109	
16	431	472,743	10.8	120		
16.5	431.5	486,669	5.5	125		

**Date:** July 5, 2016  
**Project No.:** 1648164  
**Subject:** FGD-A, FGD-B, FGD-C Area Capacity Curves  
**Project Short Title:** Luminant CCR Support

**Made by:** AGM  
**Checked by:** VK  
**Reviewed by:** JBF

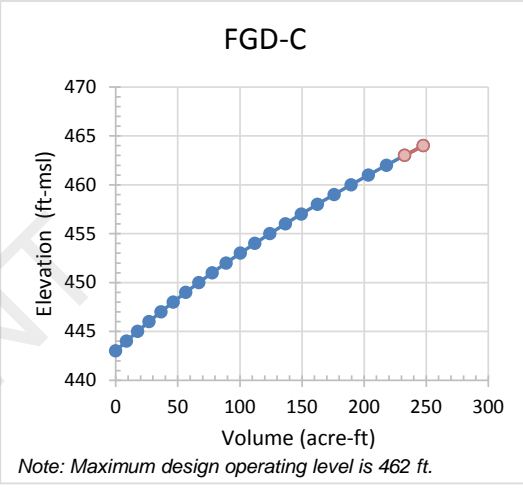	Stage (ft)	Elevation (ft-msl)	Area (ft <sup>2</sup> )	Incremental Volume (acre-ft)	Cumulative Volume (acre-ft)	Area Capacity Curve
FGD-C	1	443	369,540	0	0	
	2	444	382,825	9	9	
	3	445	396,177	9	18	
	4	446	409,600	9	27	
	5	447	423,093	10	36	
	6	448	436,657	10	46	
	7	449	450,291	10	56	
	8	450	463,995	10	67	
	9	451	477,769	11	78	
	10	452	491,614	11	89	
	11	453	505,529	11	100	
	12	454	519,514	12	112	
	13	455	533,570	12	124	
	14	456	547,696	12	137	
	15	457	561,892	13	149	
	16	458	576,151	13	162	
	17	459	590,467	13	176	
	18	460	604,840	14	189	
	19	461	619,269	14	204	
	20	462	633,755	14	218	
	21	463	648,297	15	233	
	22	464	662,896	15	248	

  
 10/10/16  


Professional Engineering Firm  
 Registration Number F-2578